

No 53 Ship

Length 103 ft. Bdrth 20 ft Dpth 11 ft


Class 100 A1 For Fishing Purposes



Lloyds Nos

$\frac{1}{2}$ Girth 17.475
 $\frac{1}{2}$ Bath 10.0
 ' Dpth 12.833⁵⁶ No
 40.088
 102.
 4088 2 No

40.08, 24 h
40.88 2nd ho

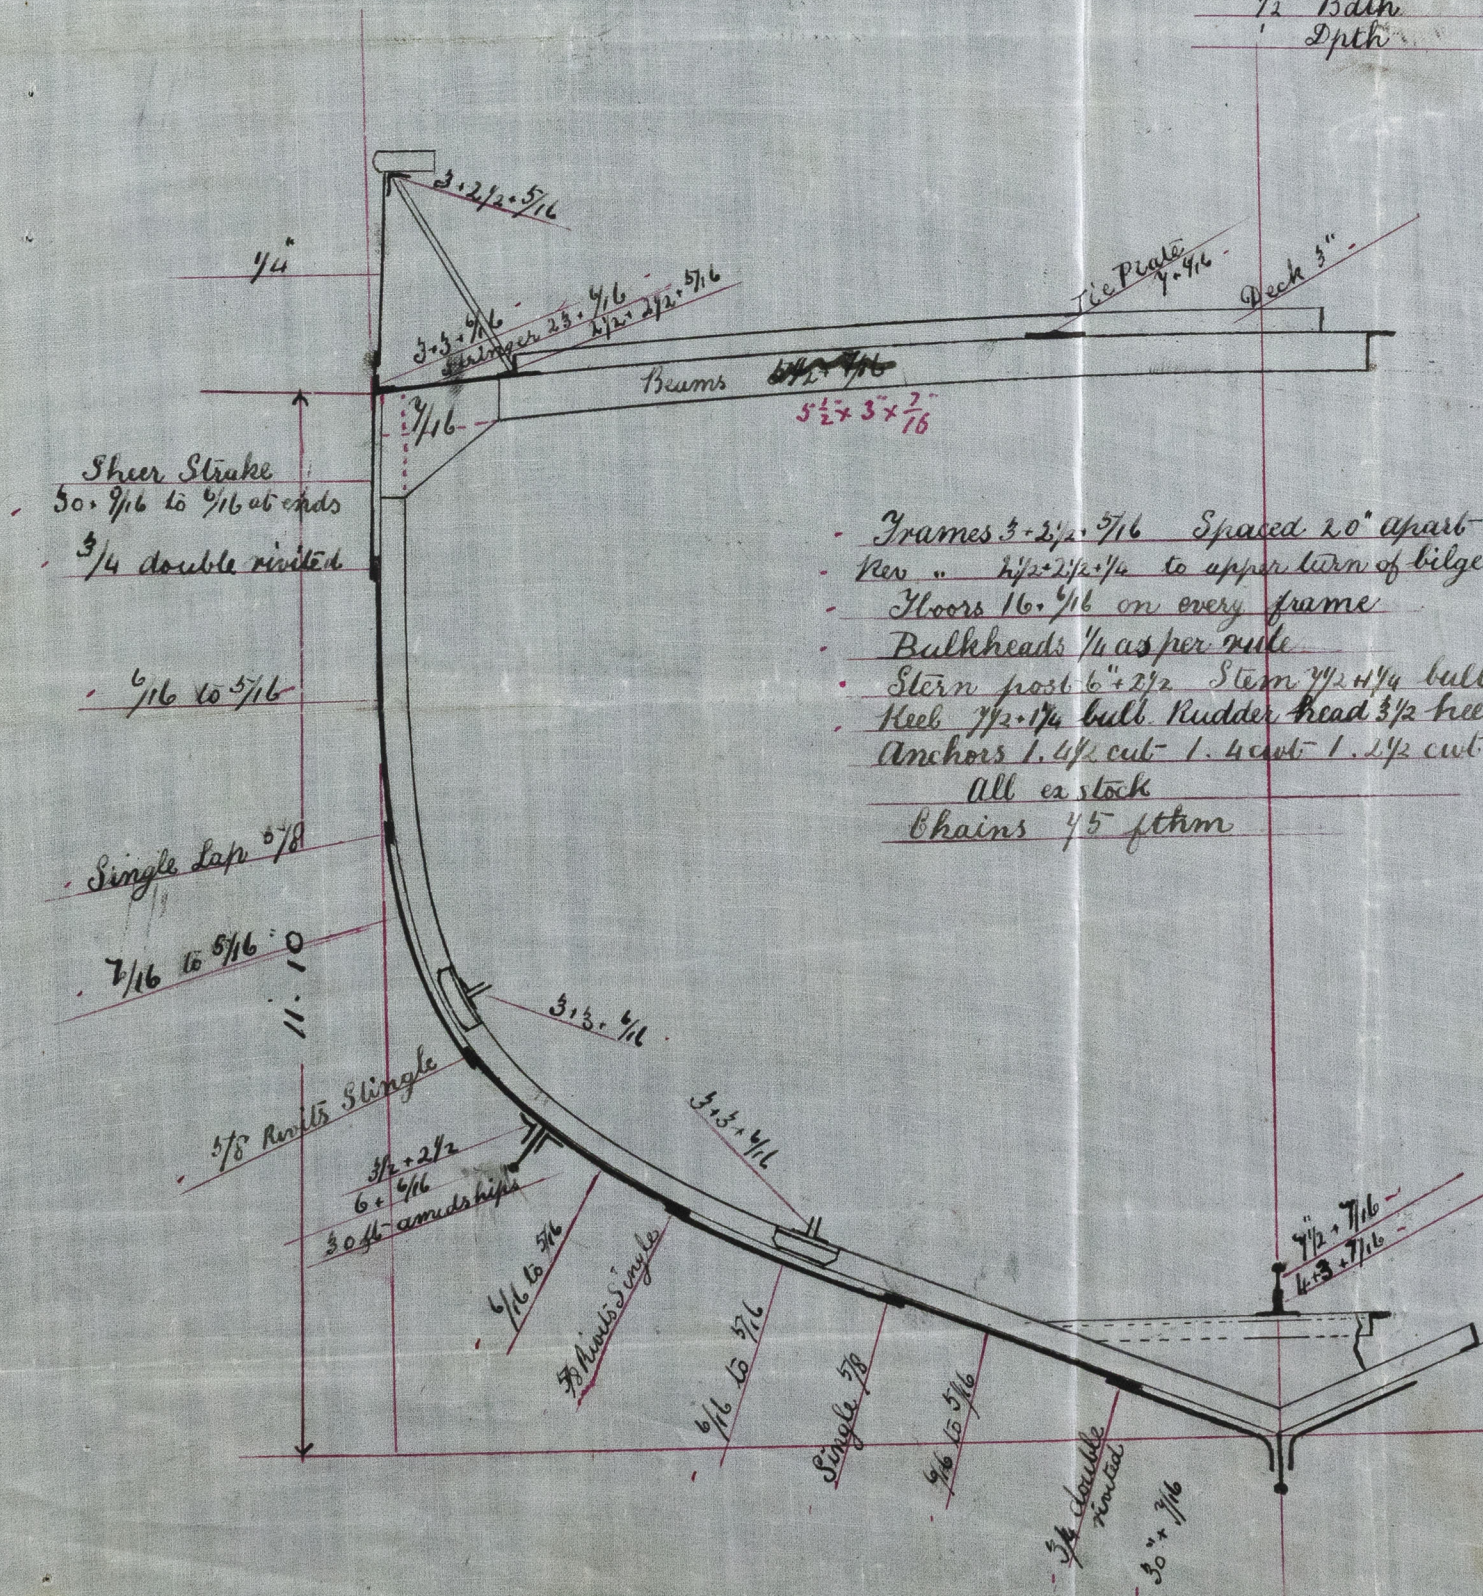




16/5/90

© 2019

Lloyd's Register
Foundation

HUL403-000