


A circular purple ink stamp. The outer ring contains the text "COOK, MELTON & GEMMELL" at the top and "SOUTH BRIDGE NO 1000" at the bottom, separated by small stars. The center of the stamp contains the text "IRON SHIPBUILDERS" in a bold, serif font.

No 56 Ship

Class 100 A1.

Lloyds Nos

$\frac{1}{2}$ Girth 17. ~~25~~ 79
 $\frac{1}{2}$ Breadth 10. ~~22~~ 28
Depth 12. 4 33
 40 - ~~5~~ 40 n°
 92
 3717 2nd n°

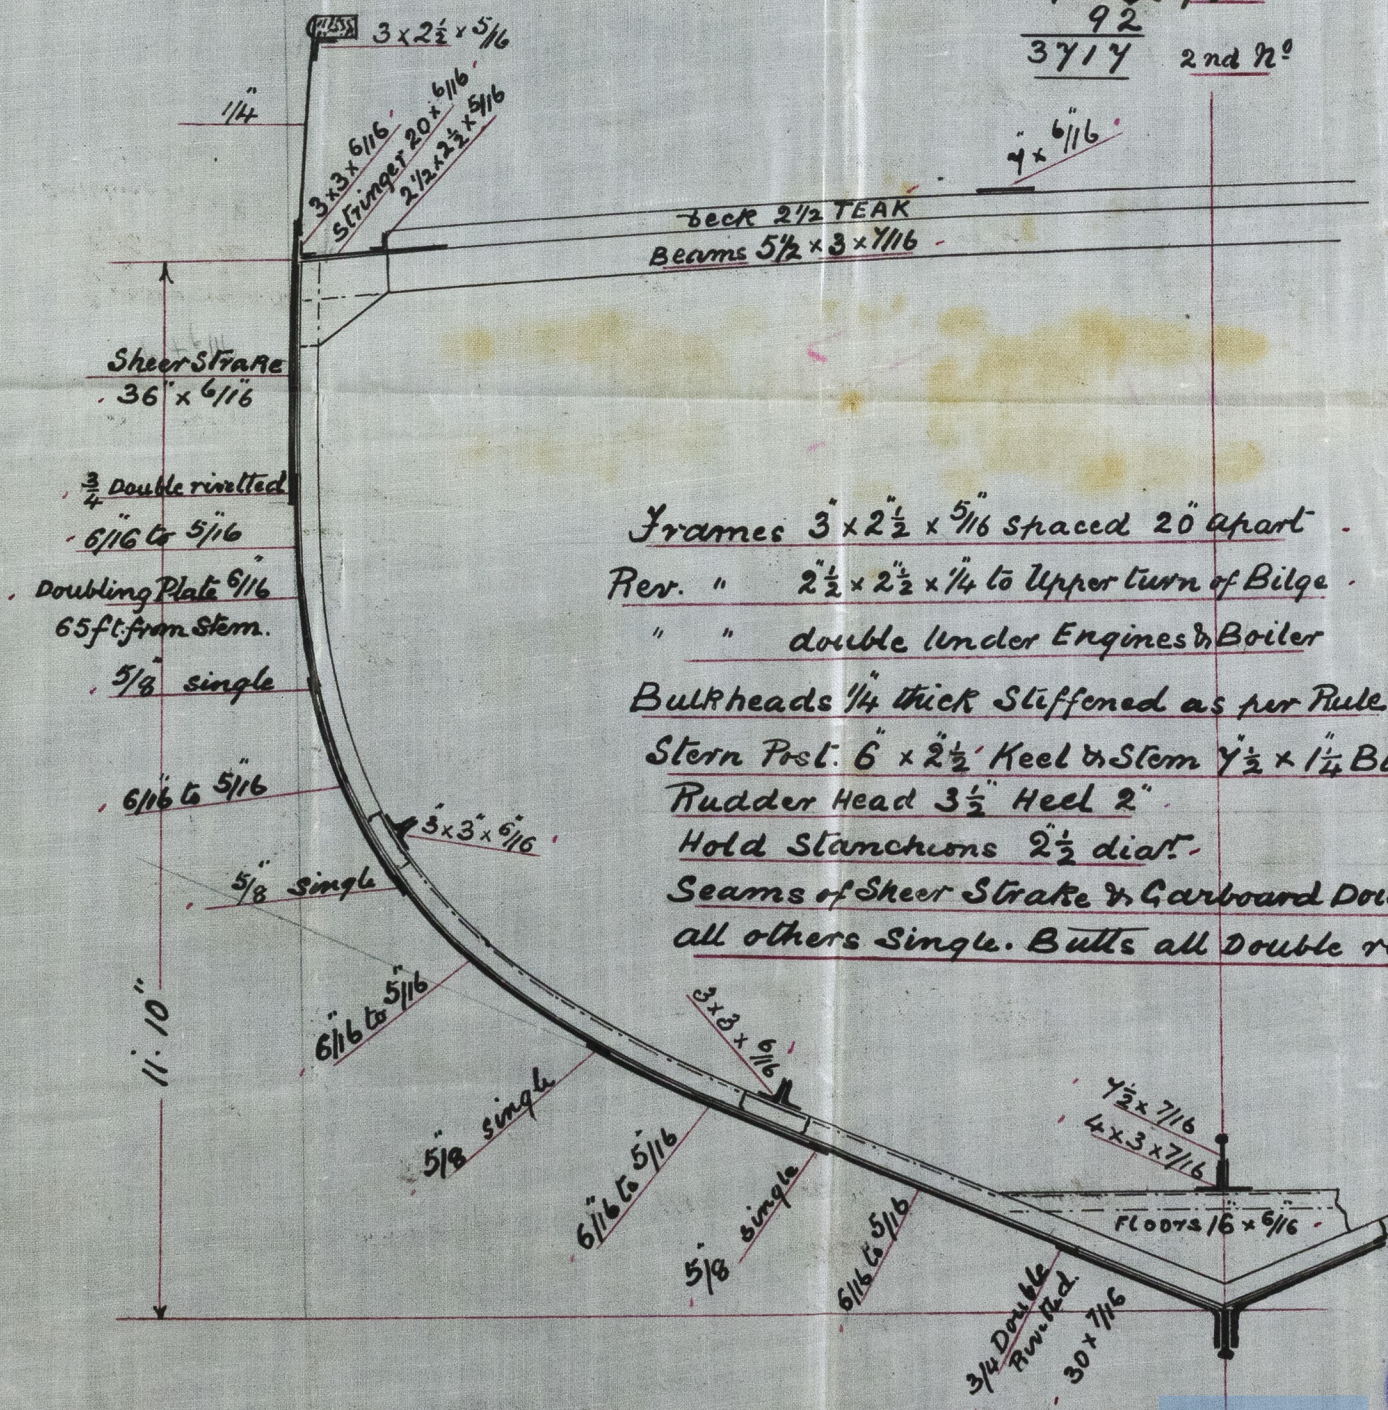

Frames $3 \times 2\frac{1}{2} \times \frac{5}{16}$ spaced 20" apart.

Rev. " $2\frac{1}{2} \times 2\frac{1}{2} \times \frac{1}{4}$ to upper turn of Bilge

" " double (under Engines & Boiler)

Bulkheads $\frac{1}{4}$ " thick Stiffened as per Rule.

Stern Post. $6'' \times 2\frac{1}{2}''$ Keel to Stern $7\frac{1}{2}'' \times 1\frac{1}{4}''$ Bulb.

Rudder Head $3\frac{1}{2}$ " Heel 2"

Hold Stanchions $2\frac{1}{2}$ dia.

Seams of Sheer Strake & Garboard Double rivetted.
all others Single. Butts all Double rivetted.

J.H.
20/6/90



Lloyd's Register
Foundation

HUL403-0034