

sp "Tentonic" Hull Report to
sp "Majestic" 7679

Midship Section No 40 & 41
105' 0" x 20' 0" x 11' 0" to top of floors

Scale 1/2" = one foot

Length as per rule 103' 10 1/2"
Half M. Breadth 9' 11 1/2"
Depth Keel to MD Beam 12' 4"


Class 100A



1/2 length 17.58
1/2 Breadth 9.95
Depth 12.33
1st No 39.86
103.87

27902
31888
11958
39860

2nd No 4140.2582

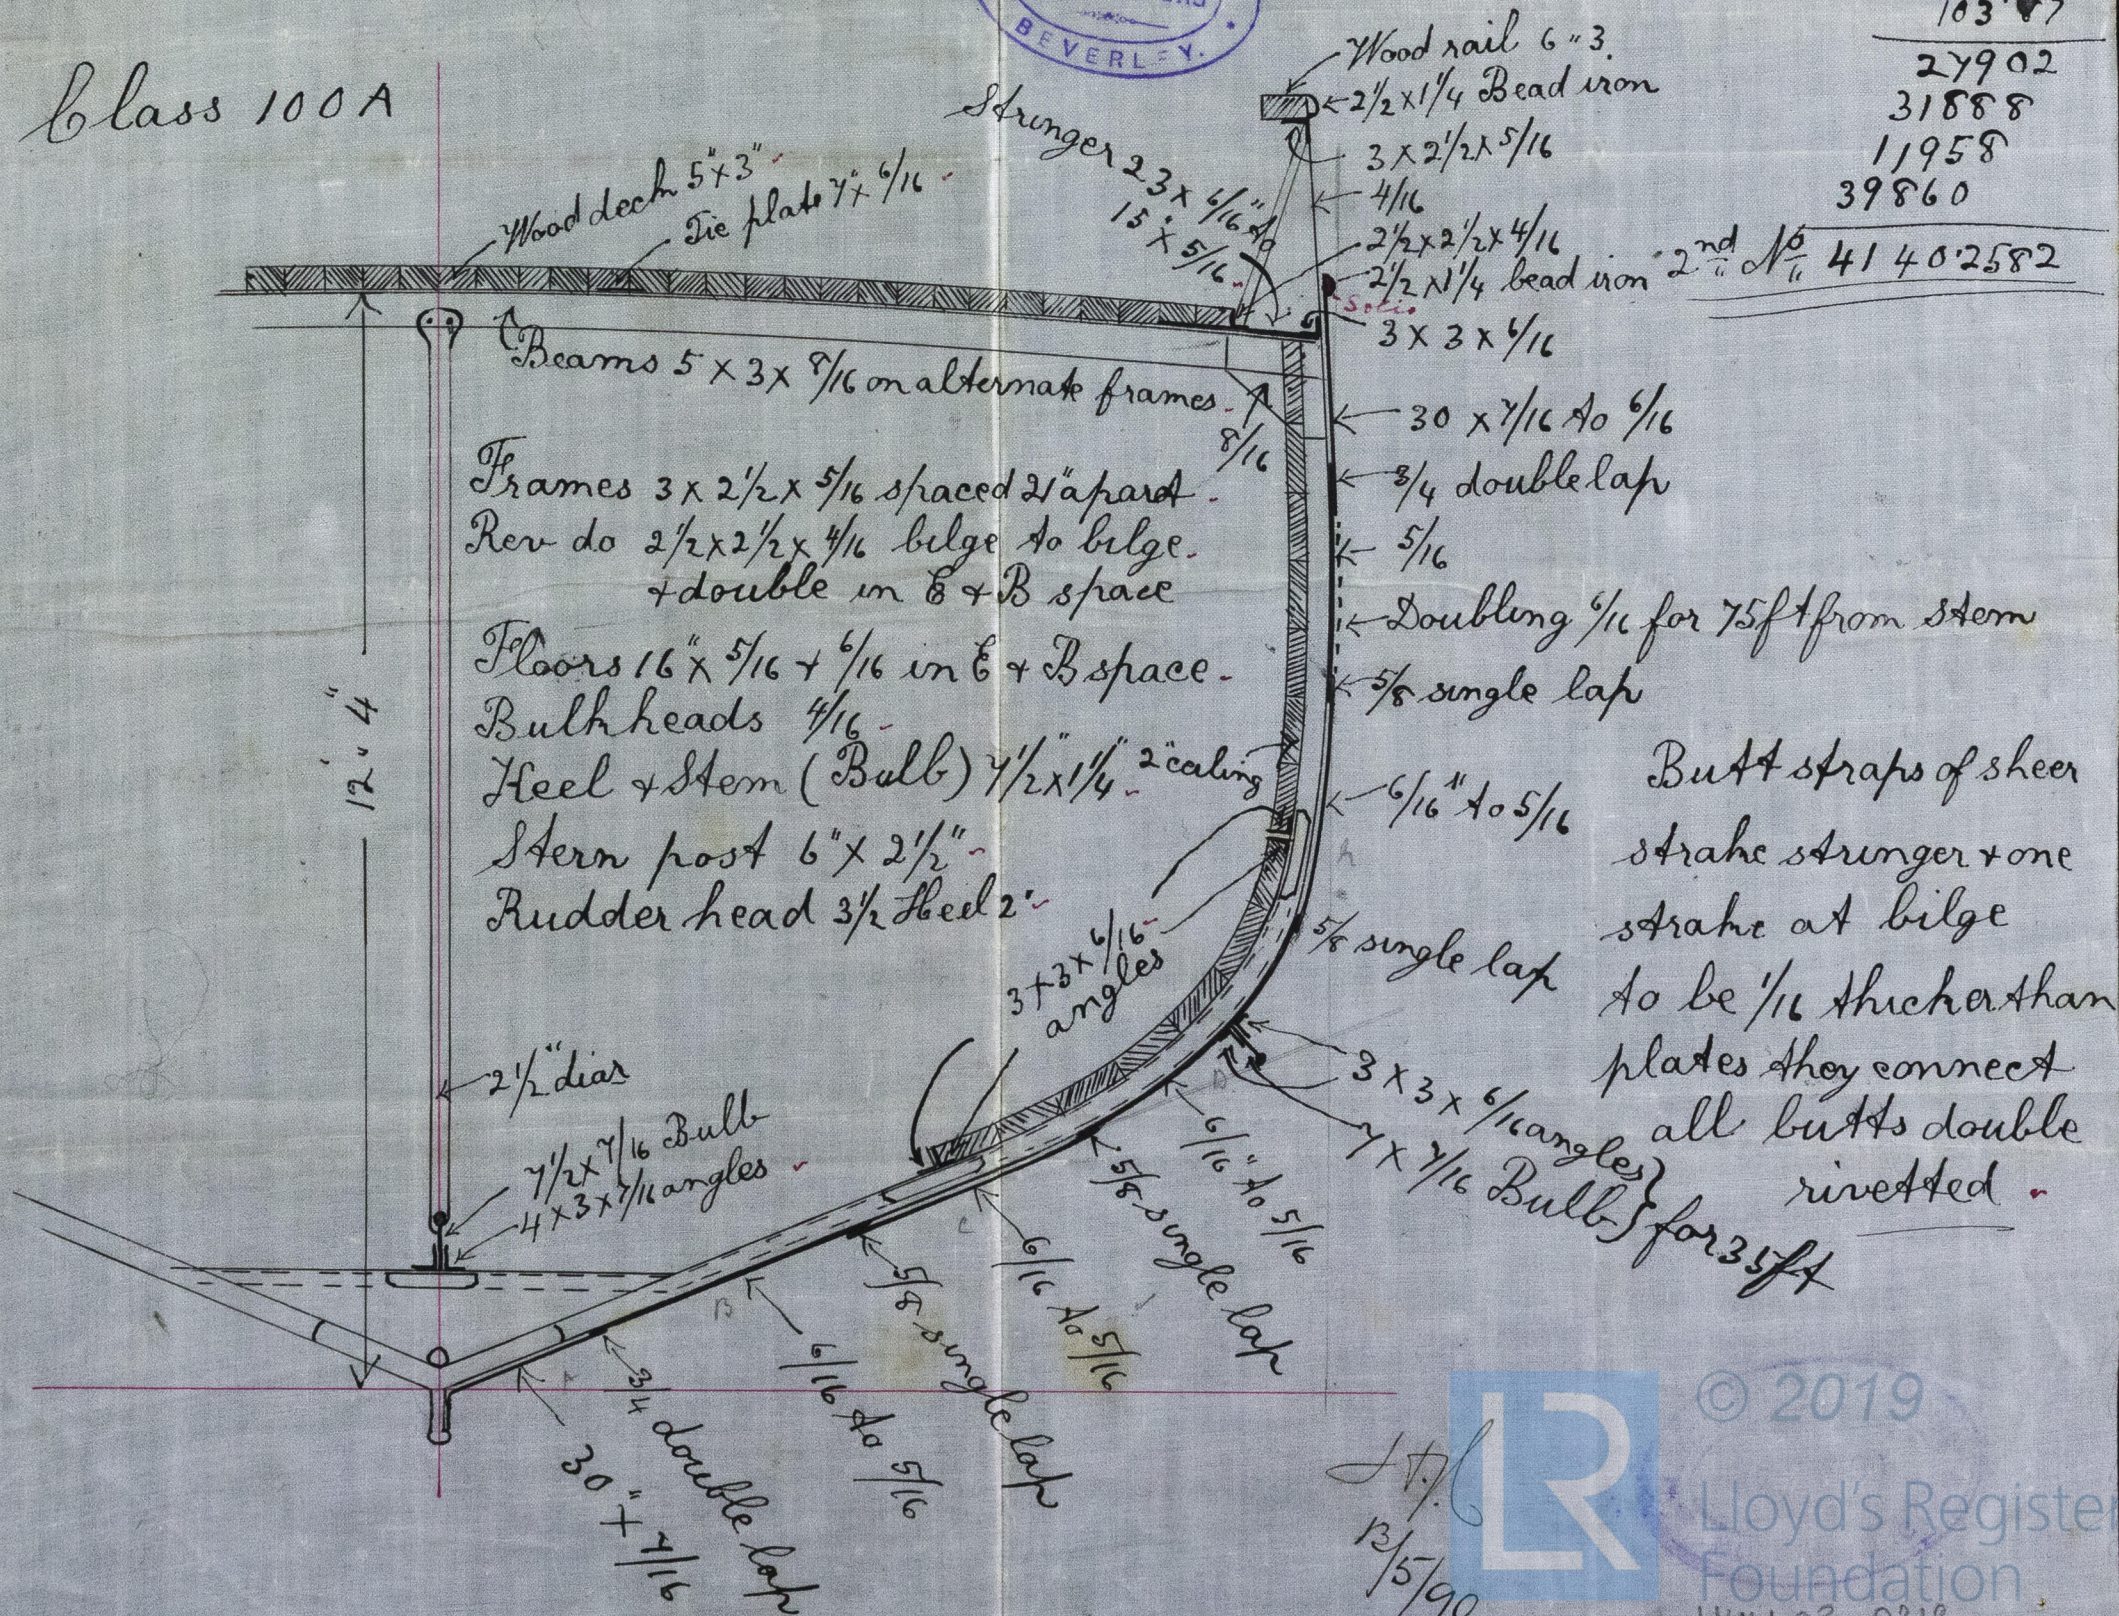

J.T.L.
13/5/90



© 2019
Lloyd's Register
Foundation
HUL403-0212