

Lloyd's Register of British and Foreign Shipping.

s/s Bombay

(Report on Vessel No. 4705 Port

Mull

No. 1748a

SHIP FORGINGS OR CASTINGS.

I have to report that the undermentioned Iron or Steel Forgings or Castings, manufactured by

The Great Forge Co.

of Pallion

for the Vessel No. 52, being built by Messrs Cochrane Cooper & Schofield

of Mull

have been inspected by me as set forth below, and found

to be, so far as can be seen, sound

The words FORGINGS or CASTINGS, IRON or STEEL, should be struck out as may be required.

Mark on Forgings.

Lloyd's

No. 1748a

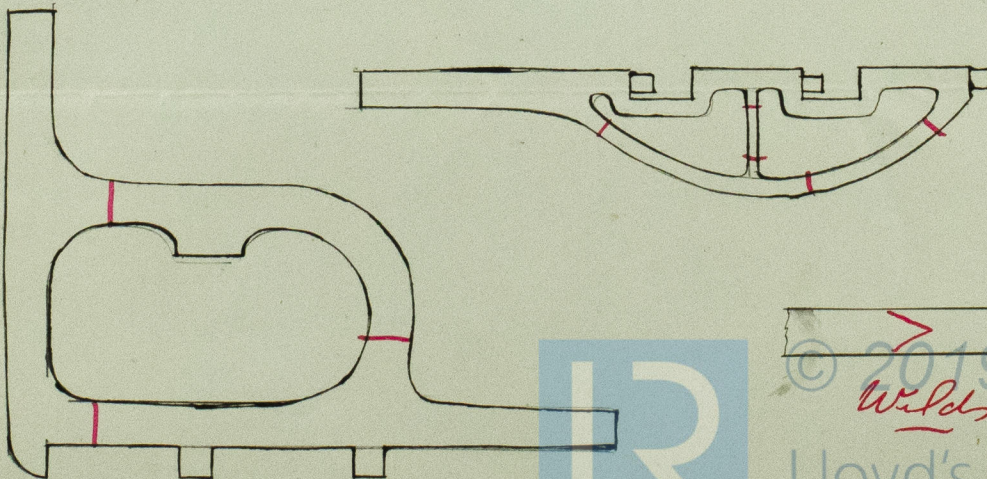
H.C.

Hugh Cannon

Sunduland

	STERN FRAME.	RUDDER FRAME.	STEM.
Material*	Scrap iron	Scrap iron	}
How made	Forged	Forged	
Dimensions	6' x 2 1/4"	3 1/2' - 2'	
Progress on Inspection .	Forged & smithed	Forged & smithed	
Dates when Inspected {	Nov 5-6-10-13-15/90	Dec 10-15-24-29/90	

SKETCHES OF FRAMES SHEWING POSITION AND DESCRIPTION OF WELDS OF FORGINGS, OR PARTICULARS OF TESTS APPLIED TO CASTINGS.

© 2019
WeldsLloyd's Register
Foundation