

Lloyd's Register of British and Foreign Shipping.

(Report on Vessel No. ^{s/s Omph} 7888 Port Hull)

No. 641 SHIP FORGINGS OR CASTINGS.

I have to report that the undermentioned Iron or ~~Steel~~ Forgings or ~~Castings~~, manufactured by Messrs W Belland & Co of Wellington Quay for the Vessel No. 63, being built by Messrs Cochran Cooper & Schofield of Hull have been inspected by me as set forth below, and found to be, so far as can be seen, sound

The words FORGINGS or CASTINGS, IRON or STEEL, should be struck out as may be required.


Mark on Forgings.

Lloyd's
No. 281B
96

John C Craig
Newcastle
18/6/91

	STERN FRAME.	RUDDER FRAME.	STEM.
Material*	<u>Scrap Iron</u>	<u>Scrap Iron</u>	/
How made	<u>Forged</u>	<u>Forged</u>	
Dimensions	<u>6 - 2 1/2</u>	<u>3 1/2 - 2</u>	
Progress on Inspection	<u>Smithed & Tempered</u>	<u>Smithed & Tempered</u>	
Dates when Inspected	<u>April 7 - 21 / 91</u>	<u>June 1 - 8 / 91</u>	

SKETCHES OF FRAMES SHEWING POSITION AND DESCRIPTION OF WELDS OF FORGINGS, OR PARTICULARS OF TESTS APPLIED TO CASTINGS.

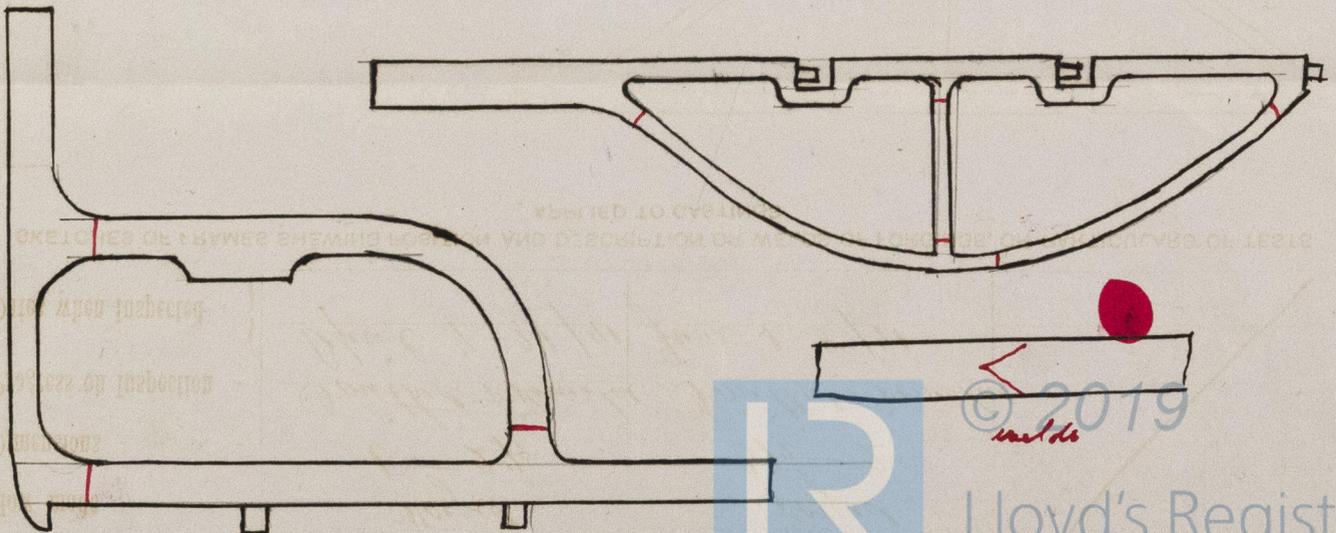

* If of Iron, state whether scrap or puddled Iron.

