

Hull

Lloyd's Register of British and Foreign Shipping

(Report on Vessel No. 7888 Port _____)



No. 5²/4

SHIP FORGINGS OR CASTINGS

The words FORGINGS or CASTINGS, IRON or STEEL, should be struck out as may be required.

I have to report that the undermentioned ~~Iron or Steel Forgings or Castings~~, manufactured by Messrs W. Belland & Co. of Wellington Quay for the Vessel No. 62, being built by Messrs Cochran Cooper & Schofield of Hull have been inspected by me as set forth below, and found to be, so far as can be seen, sound

Mark on Forgings.


Lloyd's
No. 28013
76

John C Craig
Newcastle

11/4/91

	STERN FRAME.	RUDDER FRAME.	STEM.
Material*	<u>Scrap Iron</u>	<u>Scrap Iron</u>	/
How made	<u>Forged</u>	<u>Forged</u>	
Dimensions	<u>6 - 2 1/2</u>	<u>3 1/2 - 2</u>	
Progress on Inspection	<u>Smithed</u>	<u>Smithed</u>	
Dates when Inspected	<u>February 25</u> <u>March 3/91</u>	<u>March 26</u> <u>April 7/91</u>	

SKETCHES OF FRAMES SHEWING POSITION AND DESCRIPTION OF WELDS OF FORGINGS, OR PARTICULARS OF TESTS APPLIED TO CASTINGS.

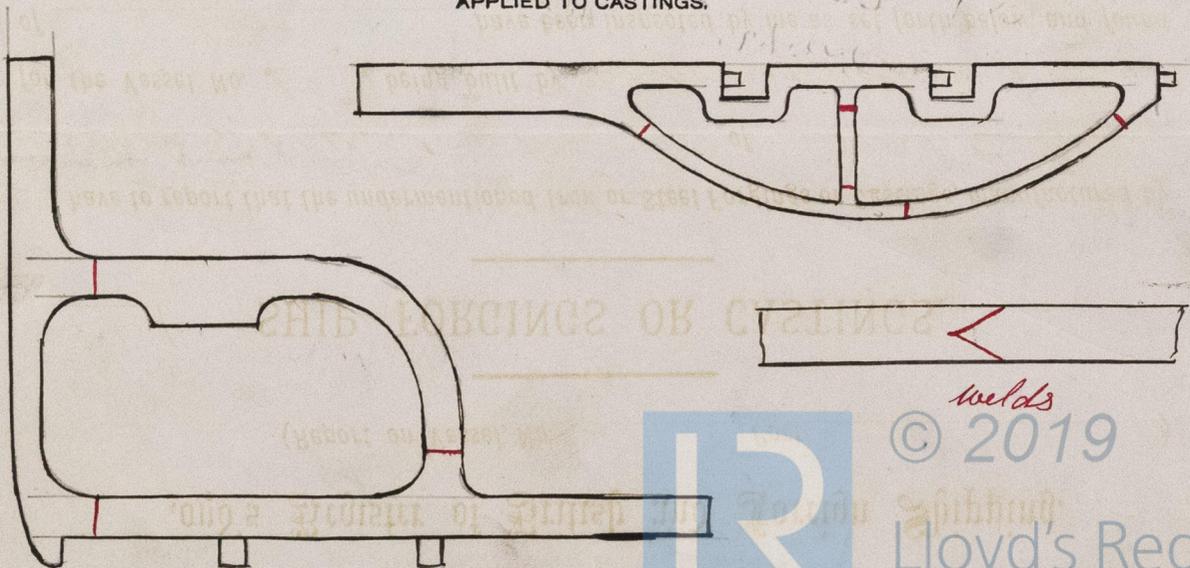

welds



© 2019

Lloyd's Register Foundation

* If of Iron, state whether scrap or puddled iron.