

Lloyd's Register of British and Foreign Shipping

(Report on Vessel No. 7888 Port Hull)



No. 542 SHIP FORGINGS OR CASTINGS.

I have to report that the undermentioned Iron ~~or Steel~~ Forgings ~~or Castings~~, manufactured by Messrs W. Blelland & Co of Wellington Quay for the Vessel No. 70, being built by Messrs Cook, Welton & Gemmell of Hull have been inspected by me as set forth below, and found to be, so far as can be seen, sound

The words FORGINGS or CASTINGS, IRON or STEEL, should be struck out as may be required.

Mark on Forgings.

Lloyd's

No. 205B

JG


John C. Craig

Newcastle

11/4/91

	STERN FRAME.	RUDDER FRAME.	STEM.
Material* - - - -	<u>Scrap Iron</u>	<u>Scrap Iron</u>	/
How made - - - -	<u>Forged</u>	<u>Forged</u>	
Dimensions - - - -	<u>6 - 2 1/2</u>	<u>3 1/2 - 2</u>	
Progress on Inspection -	<u>Smithed</u>	<u>Smithed</u>	
Dates when Inspected {	<u>March 6-13-19/91</u>	<u>March 26 April 7/91</u>	

SKETCHES OF FRAMES SHEWING POSITION AND DESCRIPTION OF WELDS OF FORGINGS, OR PARTICULARS OF TESTS APPLIED TO CASTINGS.

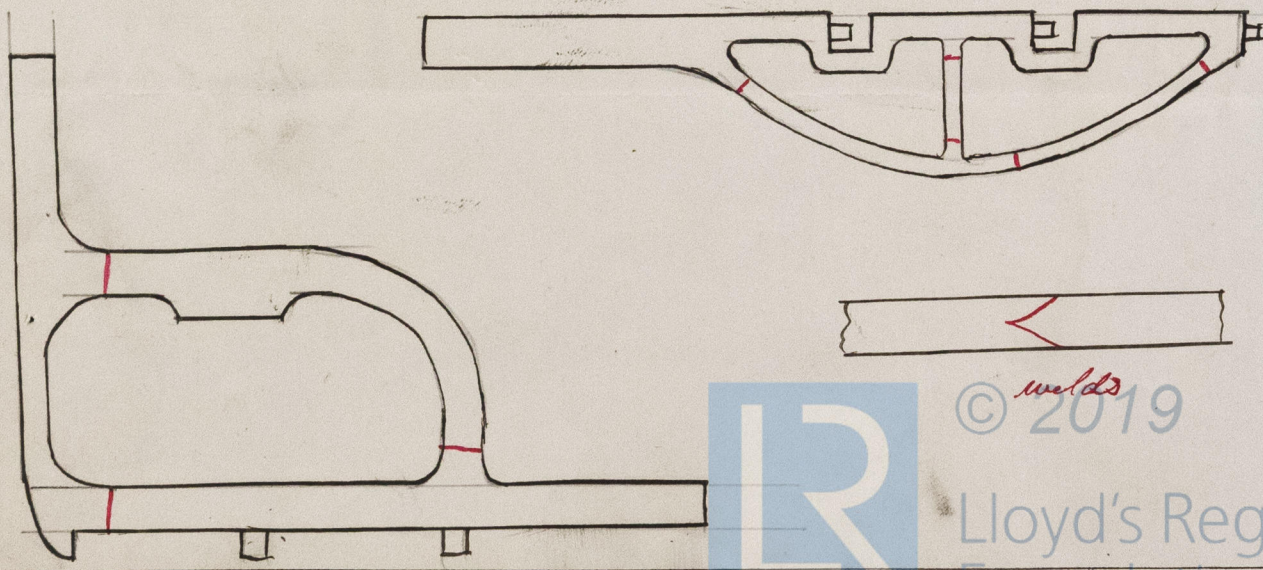

© 2019

Lloyd's Register
Foundation