


$3\frac{1}{2} \times 3\frac{1}{2} \times \frac{8}{16}$

343 & 344

Section of Double Bottom as fitted.

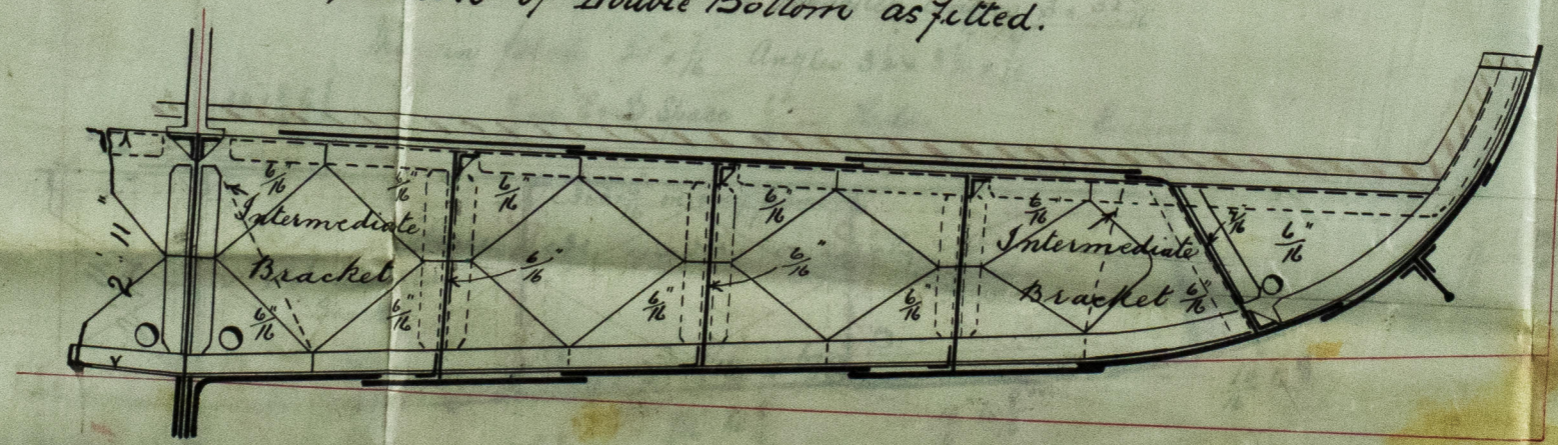

© 2019

Lloyd's Register  
Foundation

HULL04-02413