


34 3-4

PUMPING PLAN

3/2 "Lutterworth"
Hull Report No. 7898
SCALE $\frac{1}{8}$ " = 1 FOOT

3/ Leicester
Hull Reports to: 7955.

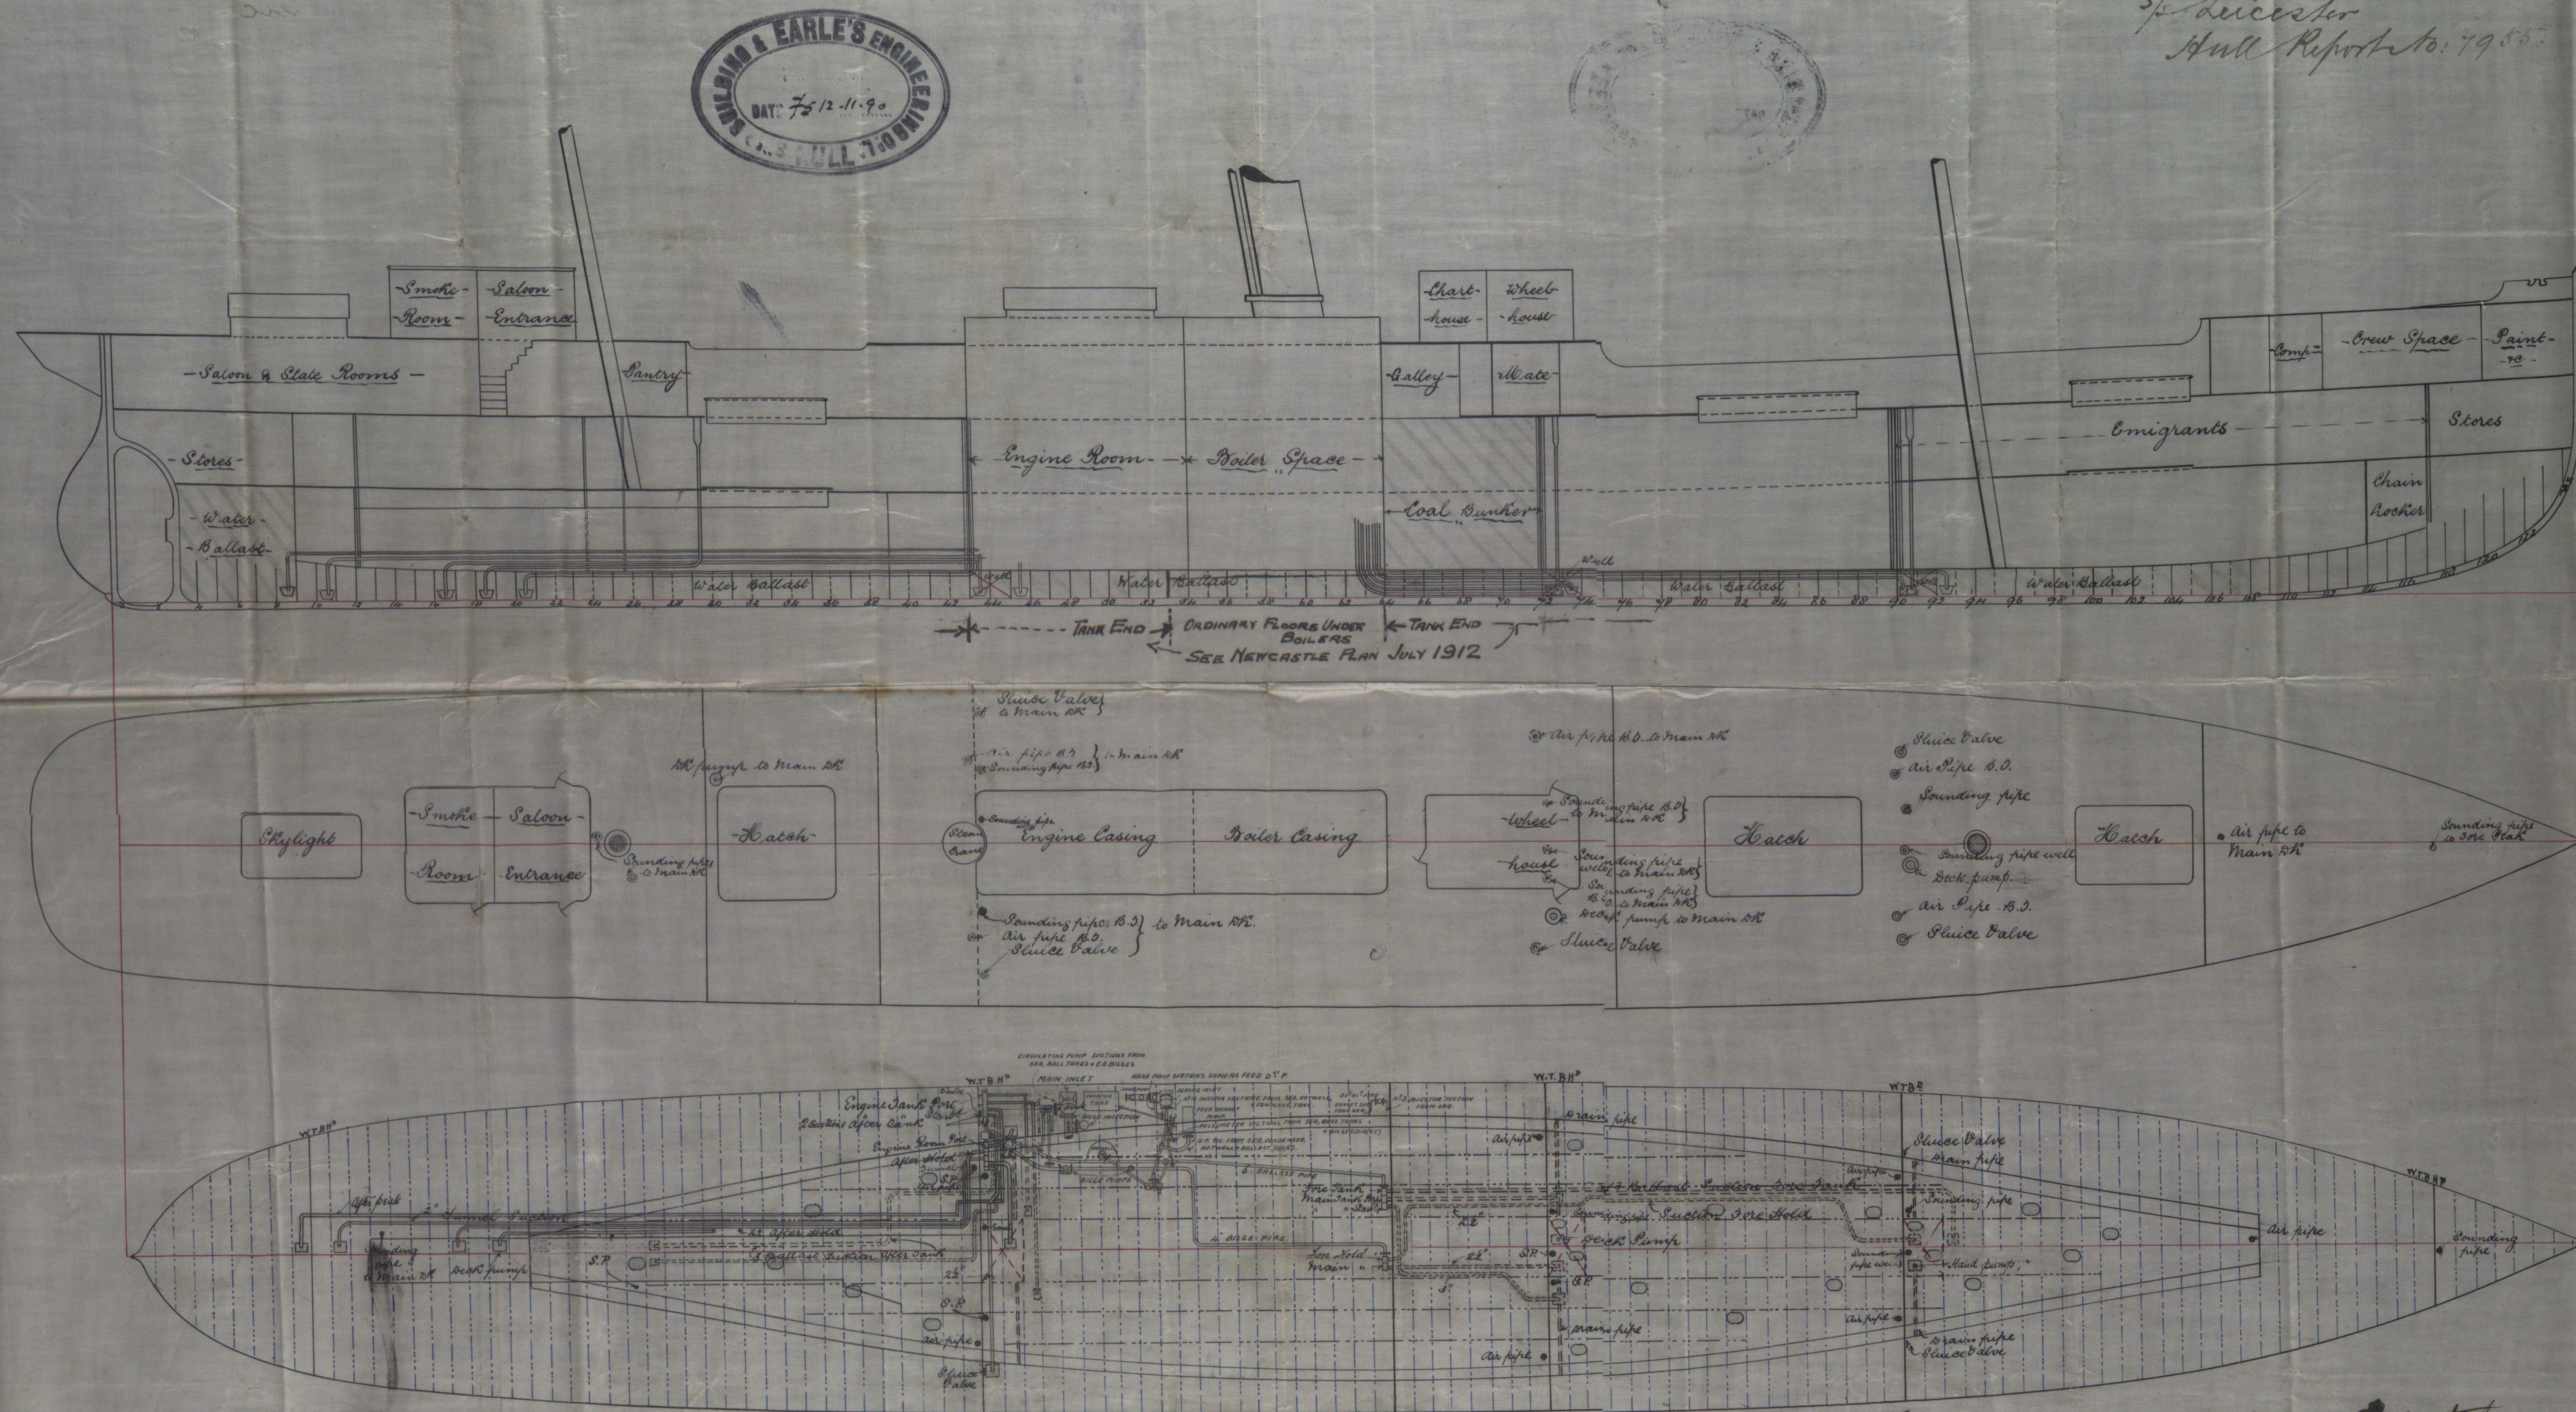

Large limber holes in
this bulkhead.

Sluice valves
on this bulkhead to
be always accessible
if fitted?

Wells in ~~halls~~ to be
in free communication
with both side gutters.

