


S/S Leatherworth
S/S Leicester





Hull Report No. 7898
7955

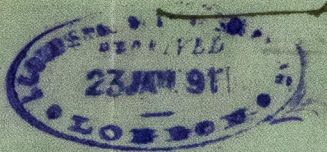

— S/S Nos 343 and 344 —

Proposed substitution of steam suction
to each limber at fore end of After Hold in
lieu of sluice valves as submitted and
approved: additional suction tinted red.

— Scale $\frac{1}{4}$ " = 1 Foot. —

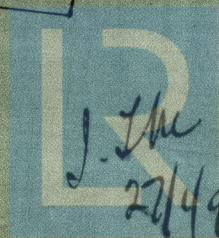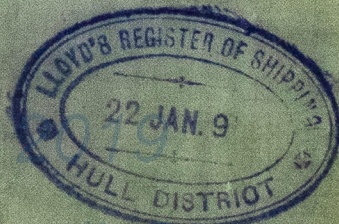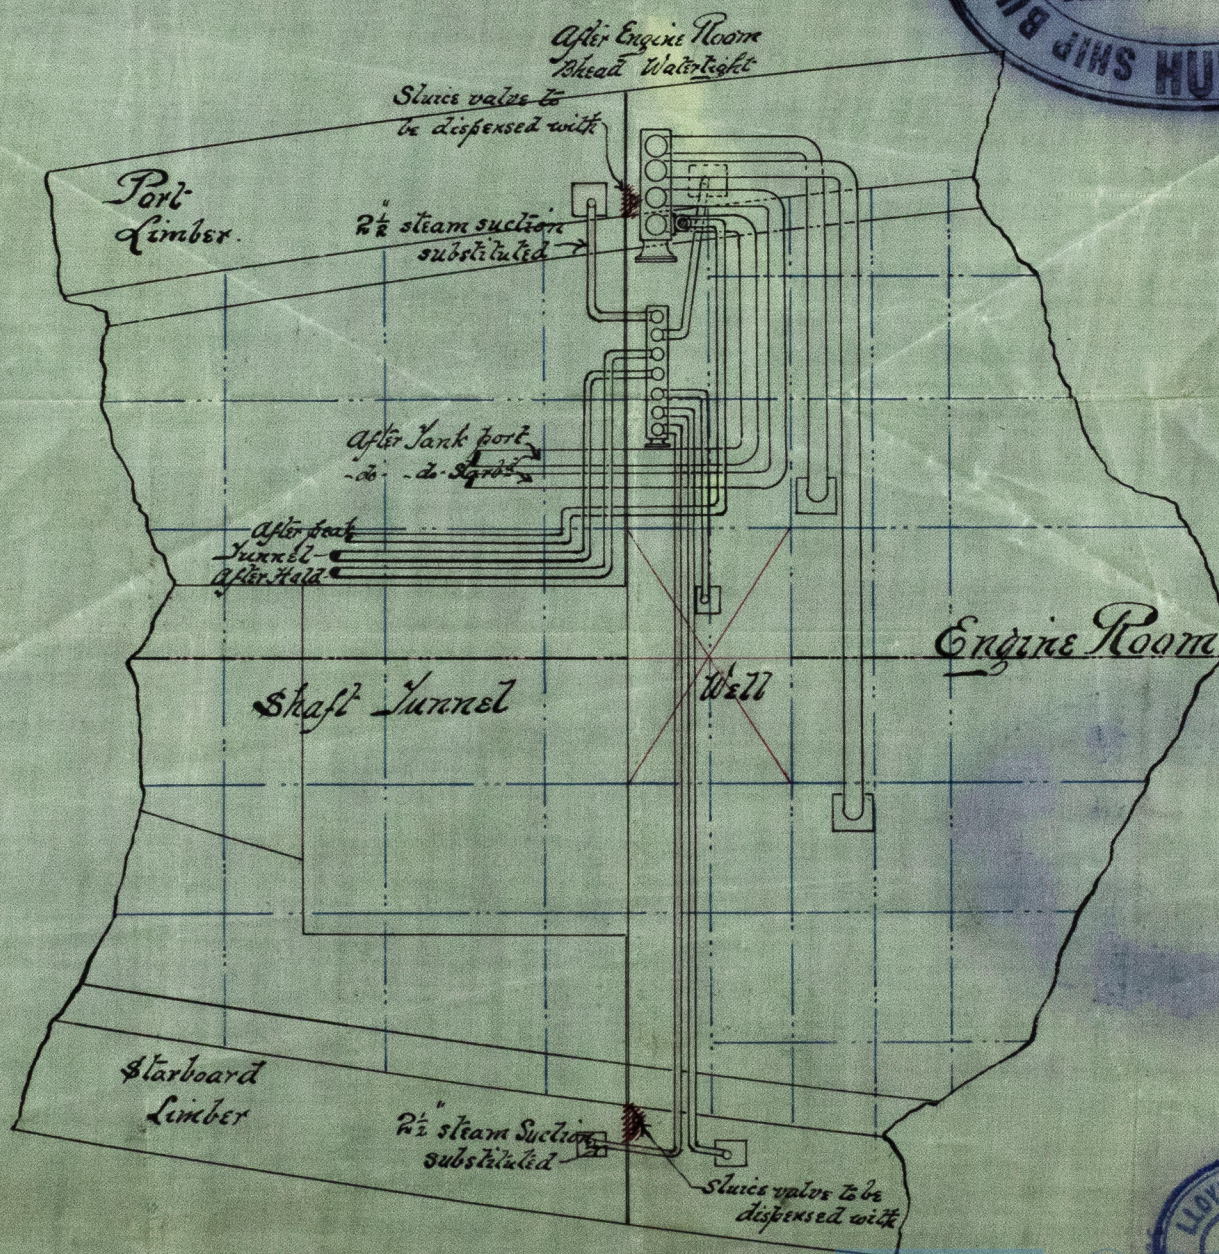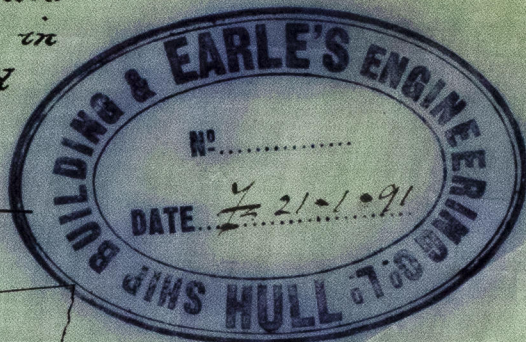

Lloyd's Register
Foundation
H04404-0257


of Leidenworth
of Leicester

Hall Reports

Nos. 7898

7955

Hull 011-0257

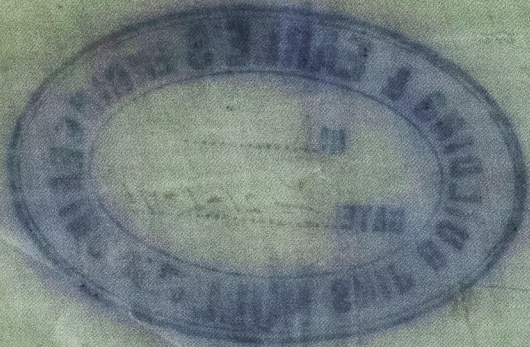

W.H.
18/1/55



© 2019

Lloyd's Register
Foundation