

S/S Jasper
Hull Report No: 2035

HVL 405-0193

Depth as per rule
Half of M. Beam
Depth heel to M. C. Beam
Class 100 A

Raised Quarter Deck



Beam
Transom
Bay
Order they connect
But double riveted
But
Steel
1"
1/2"



© 2019

Lloyd's Register
 Foundation

Length as per rule 98' " 10 1/2"
 Half M. Breadth 10' " 2 1/2"
 Depth heel to M.D. Beams 12' " 4"

Midship Section No 65
 100' " 0" x 20' " 6" x 11' " 0" Plold
 Scale 1/2" = one foot




s/s Jasper
 Hull Report No. 10

Class 100 A
 Raised Quarter Deck *Stronger in way 2. deck as per Rule.*

1/2 Girth	17.83
1/2 Breadth	10.20
Depth	12.33
1st No	40.36
	98.87
	282.52
	322.88
	322.88
	363.24
2nd No	3990.3932

5.2.91

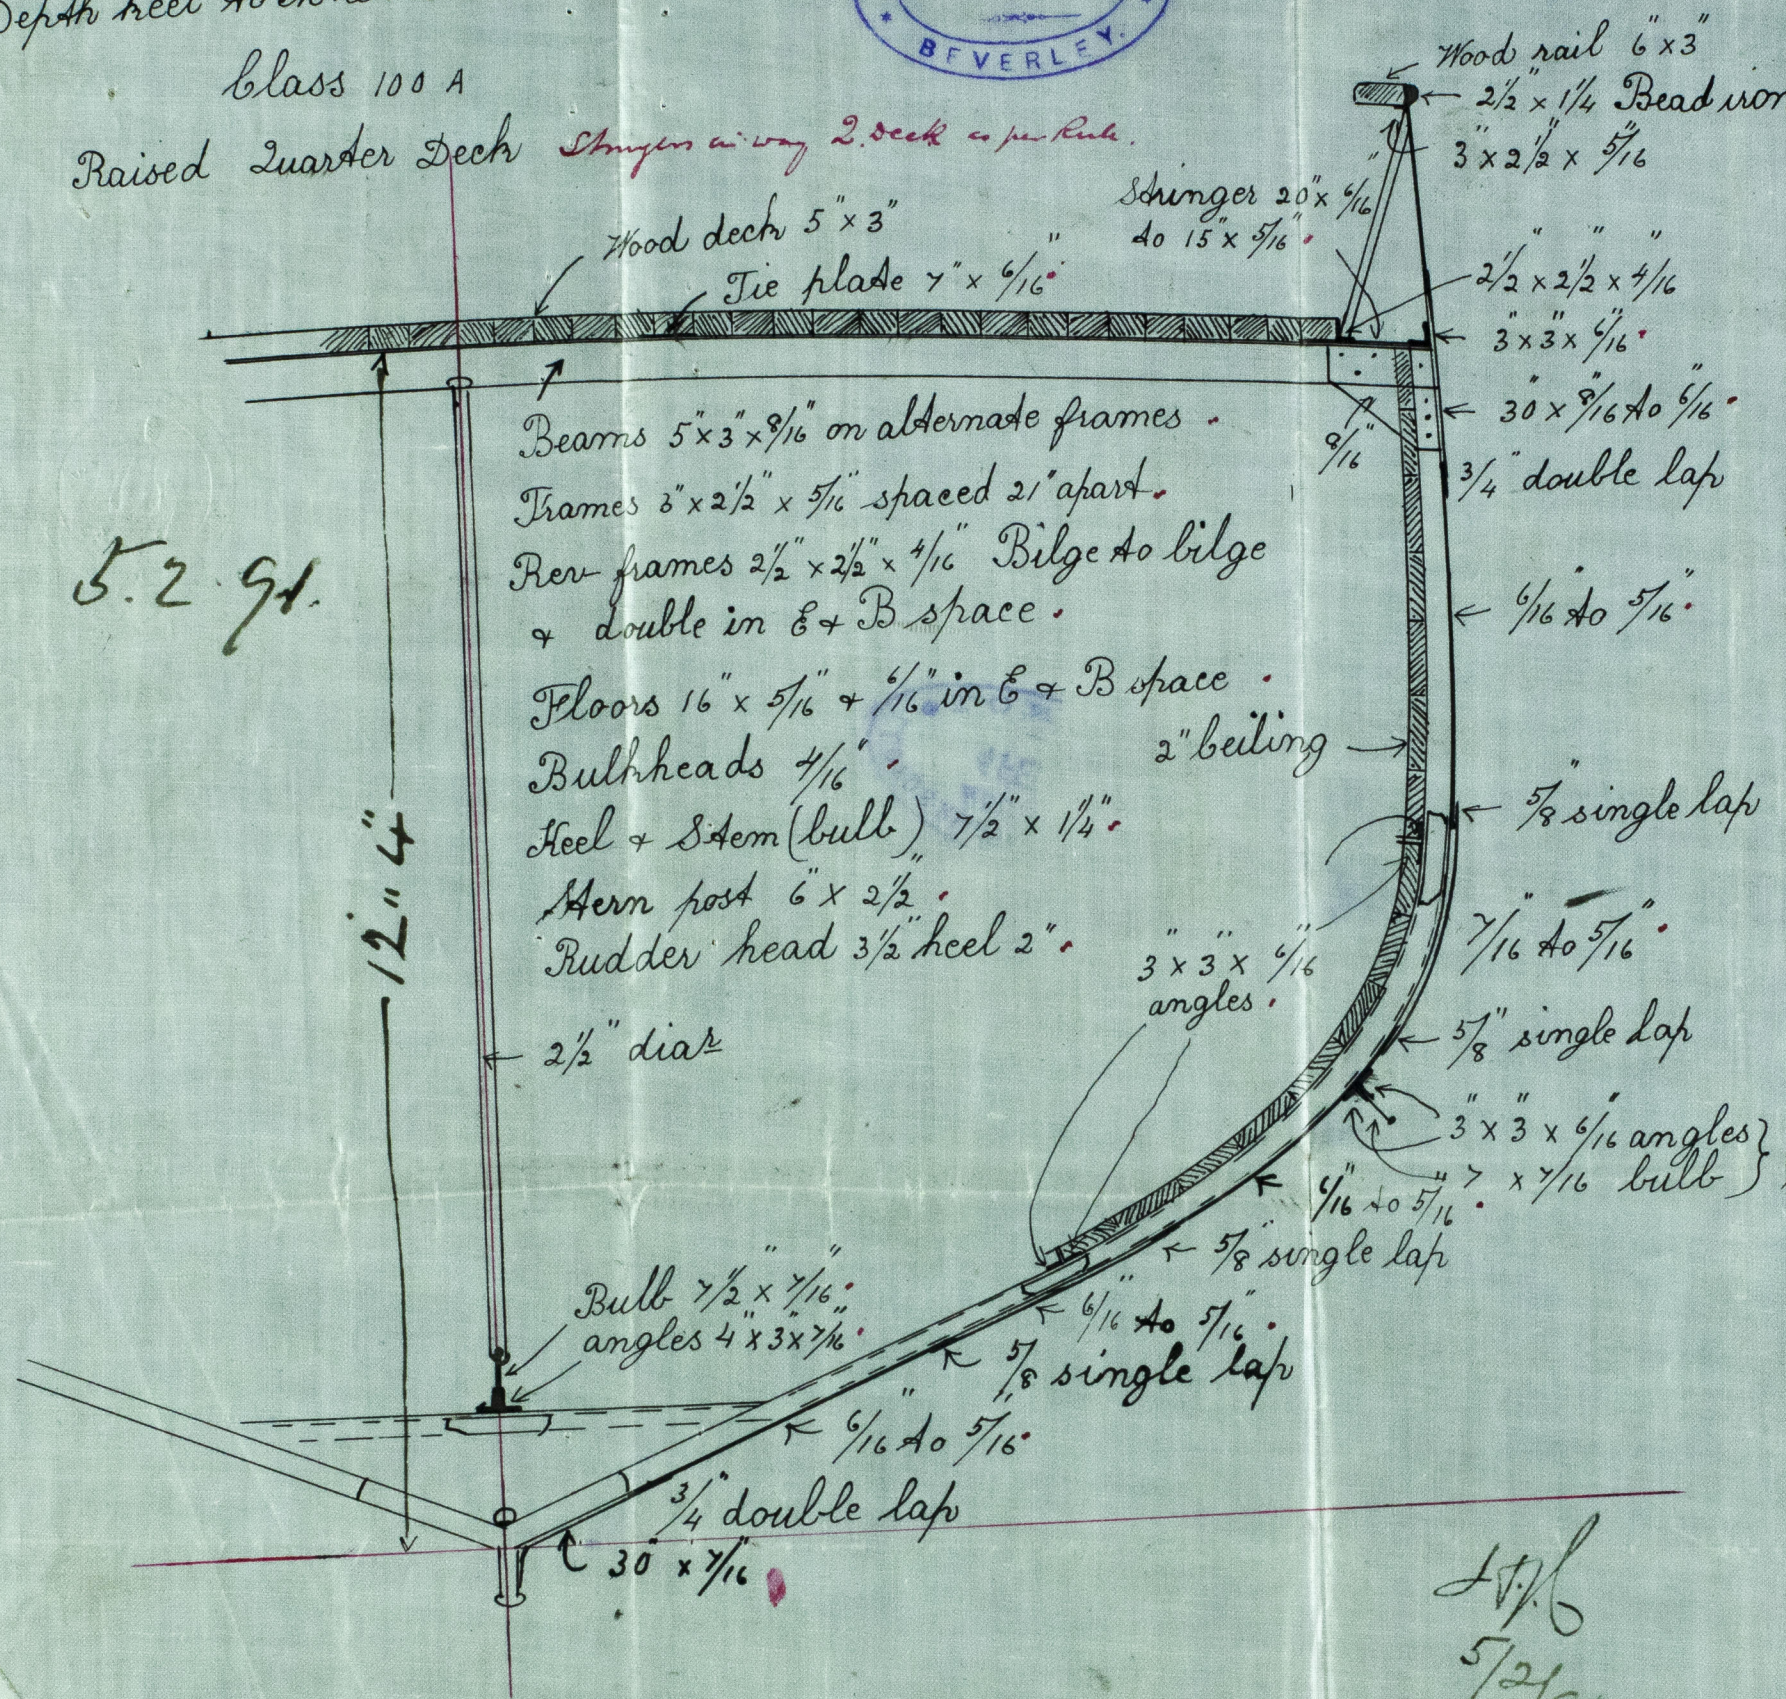


Butt straps of sheer strake
 stinger + one strake at
 bilge to be 1/16" thicker than
 plates they connect
 All butts double rivetted

wooden depth 11' " 10"

for 35 ft amidships

L.V.L.
 5/2/91

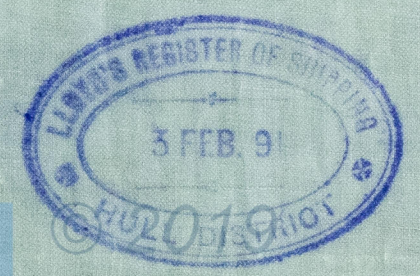

Lloyd's Register
 Foundation

HUC 405-0193