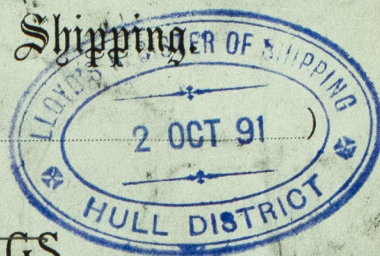


## Lloyd's Register of British and Foreign Shipping

*Jasper*(Report on Vessel No. *8035* Port*Null*No. *1744.a*

## SHIP FORGINGS OR CASTINGS.

The words FORGINGS or CASTINGS, IRON or STEEL, should be struck out as may be required.

I have to report that the undermentioned Iron or Steel Forgings or Castings, manufactured by

*The Iron Forge Co.*of *Pallion*for the Vessel No. *68*, being built by *Mrs. Cochran Cooper Schofield*of *Null* *65* have been inspected by me as set forth below, and foundto be, so far as can be seen, *sound*

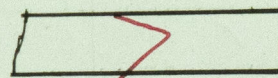
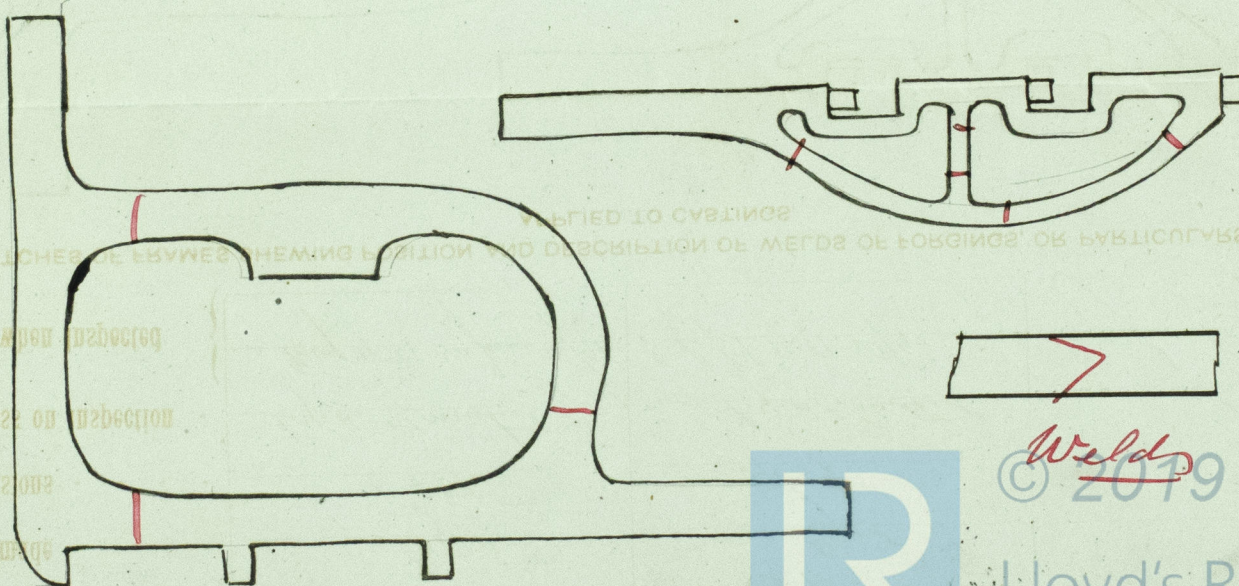
Mark on Forgings.

Lloyd's

No. *1744.a**16.6**W. J. Camm**Sunderland**1.10.91*

	STERN FRAME.	RUDDER FRAME.	STEM.
Material*	<i>Scrap iron</i>	<i>Scrap iron</i>	
How made	<i>faged</i>	<i>faged</i>	
Dimensions	<i>6 x 2 1/2'</i>	<i>3 1/2' - 2'</i>	
Progress on Inspection	<i>faged &amp; smoothed</i>	<i>faged &amp; smoothed</i>	
Dates when Inspected	<i>May 14-22-30 June 5/91</i>	<i>Sept 16-17-21/91</i>	

SKETCHES OF FRAMES SHEWING POSITION AND DESCRIPTION OF WELDS OF FORGINGS, OR PARTICULARS OF TESTS APPLIED TO CASTINGS.

*Welds*

© 2019

Lloyd's Register  
Foundation

\* If of Iron, state whether scrap or puddled iron.