

# Lloyd's Register of British and Foreign Shipping.

*s/s Agate*  
(Report on Vessel No. *8046* Port \_\_\_\_\_)

*Mull*



No. *2049A*

## SHIP FORGINGS OR CASTINGS.

The words FORGINGS or CASTINGS, IRON or STEEL, should be struck out as may be required.

I have to report that the undermentioned Iron or Steel Forgings or Castings, manufactuerd by

*The Iron Forge Co*

of *Pallin*

for the Vessel No. *66*, being built by *Cochrane Cooper Schofield*

of *Mull*

have been inspected by me as set forth below, and found

to be, so far as can be seen, *sound*

Mark on Forgings.

Lloyd's  
No. *2049A*  
*No. 6*


*W. Cameron*

*Sundaland*

*16/9/91*

	STERN FRAME.	RUDDER FRAME.	STEM.
Material*	<i>Scrap iron</i>	<i>Scrap iron</i>	
How made	<i>Forged</i>	<i>Forged</i>	
Dimensions	<i>6" x 2 1/2"</i>	<i>3 1/2" - 2"</i>	
Progress on Inspection	<i>Smithed</i>	<i>Forged Smithed</i>	
Dates when Inspected	<i>July 11/91</i>	<i>Aug 5-10-14-20/91</i>	

SKETCHES OF FRAMES SHEWING POSITION AND DESCRIPTION OF WELDS OF FORGINGS, OR PARTICULARS OF TESTS APPLIED TO CASTINGS.

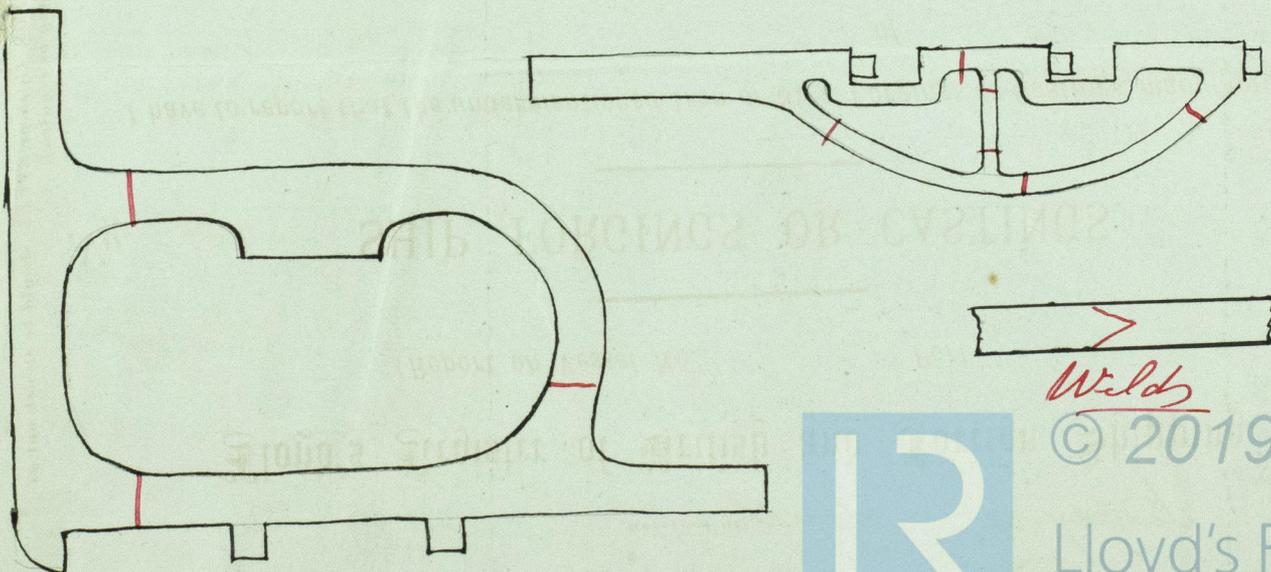

\* If of Iron, state whether scrap or puddled Iron.

