

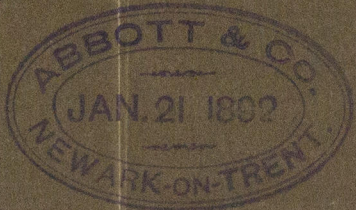


Dr: 23.1.92

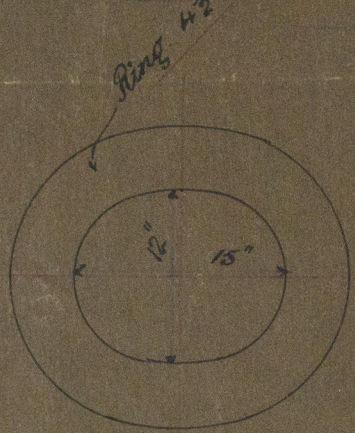


Donkey Boiler Supply Mainly
Hall Report No. 8205
Scale.

1 in. = 4 feet.

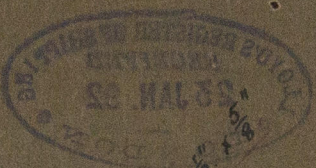


Stay tapped into this plate

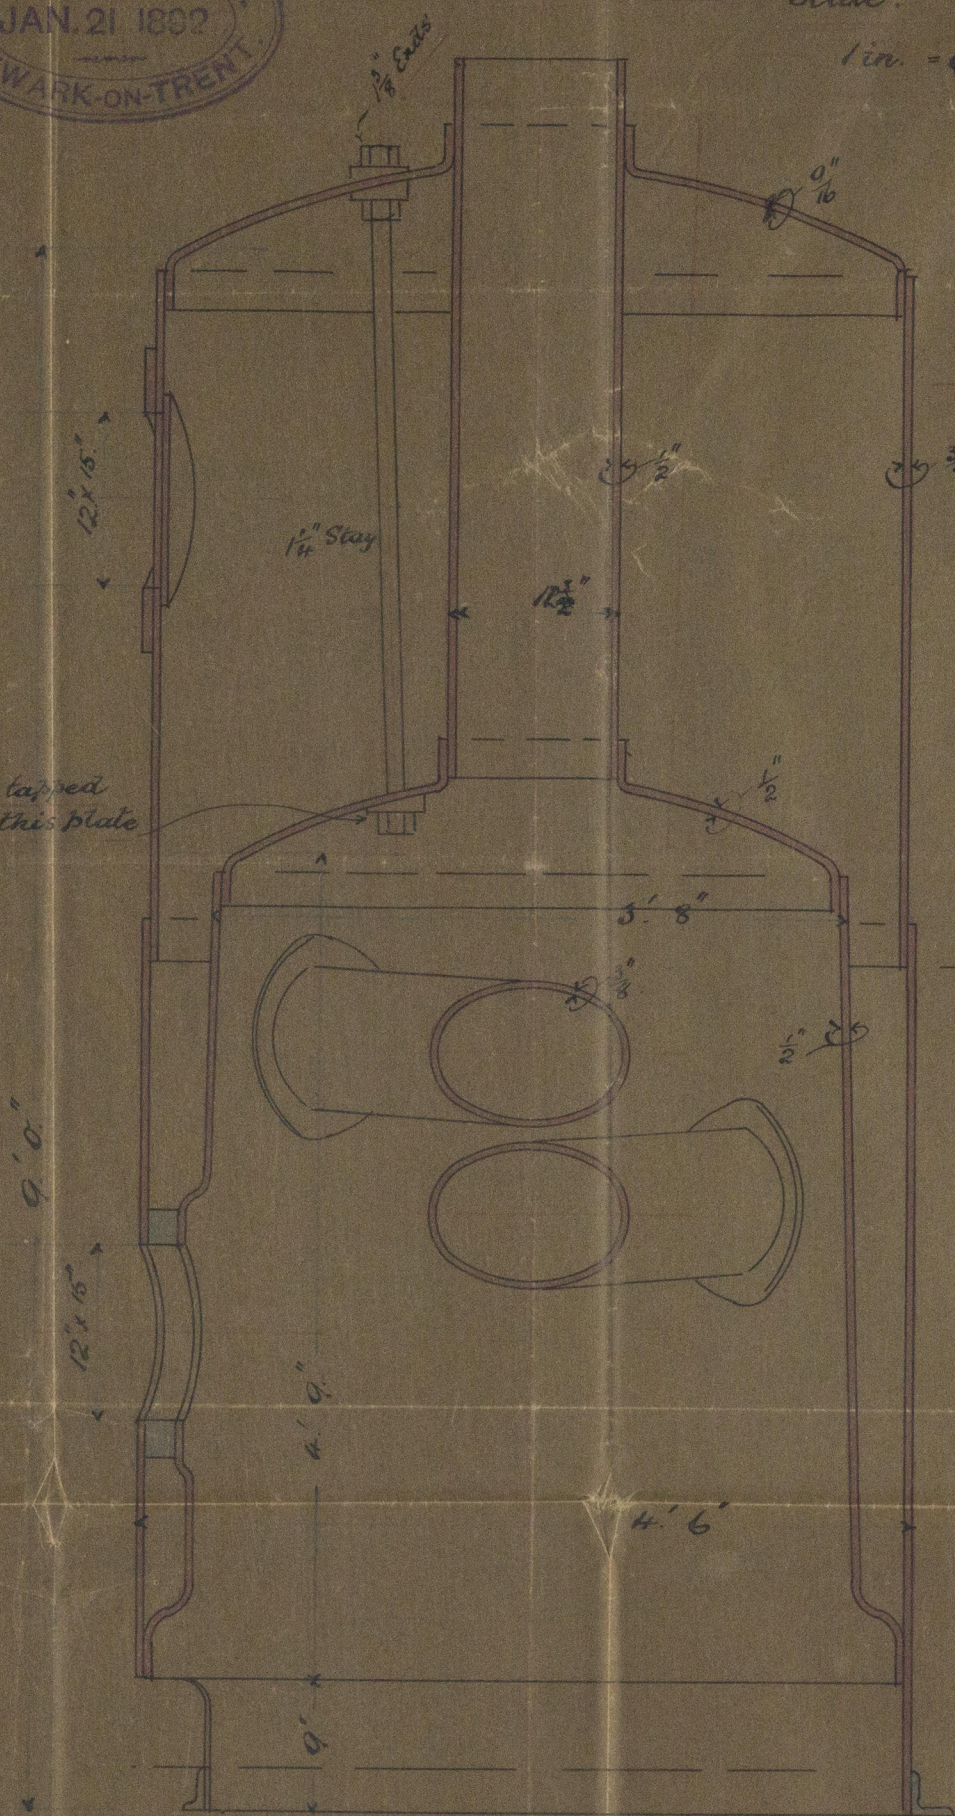




Donkey Boiler
No. 9118
for
90 lbs Working
Pressure.

All Steel plates,
rivets, & stays.
All holes drilled
in position
Vertical seam of
firebox welded.

Rivet holes
1 3/16"
pitch
27 1/2"

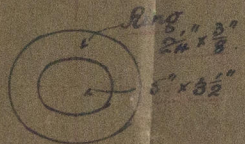

Mudholes opposite
each end of cross tubes &
3 round bottom

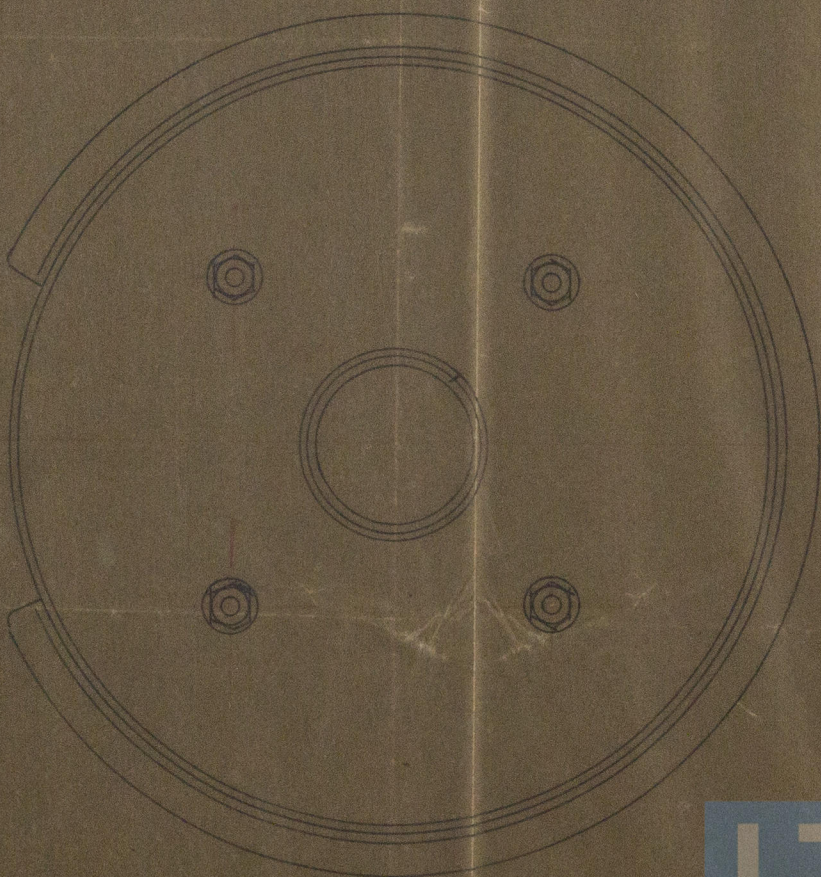 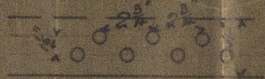

J. J. H.
23/1/92



© 2019

Lloyd's Register
Foundation

HUL406-0117

LLOYD'S REGISTER OF SHIPPING
 RECEIVED
 23 JAN. 92
 LONDON

HVL 406-0117

[Faint handwritten notes:]

10/16
10/16