


HVL406-0408

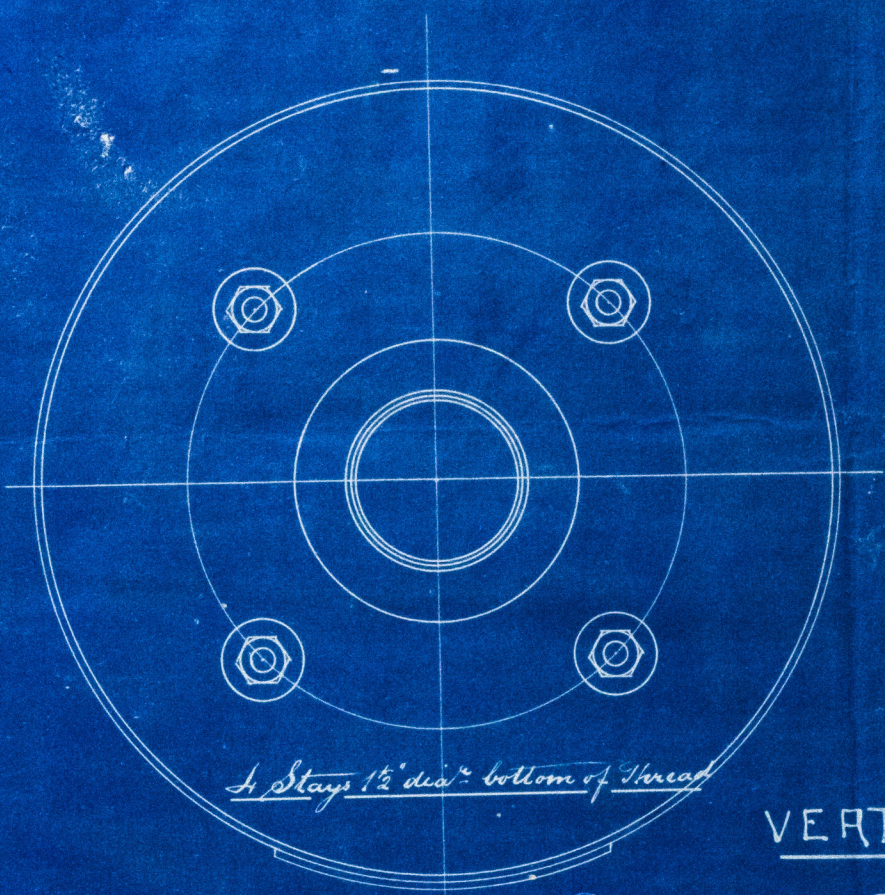

4 Stays 1 1/2 dia. bottom of head


Steel

VERTICAL DONKEY BOILER

9'0" x 4'6"

SCALE 1 INCH TO A FOOT

For Charles Ship & Co. Ltd.

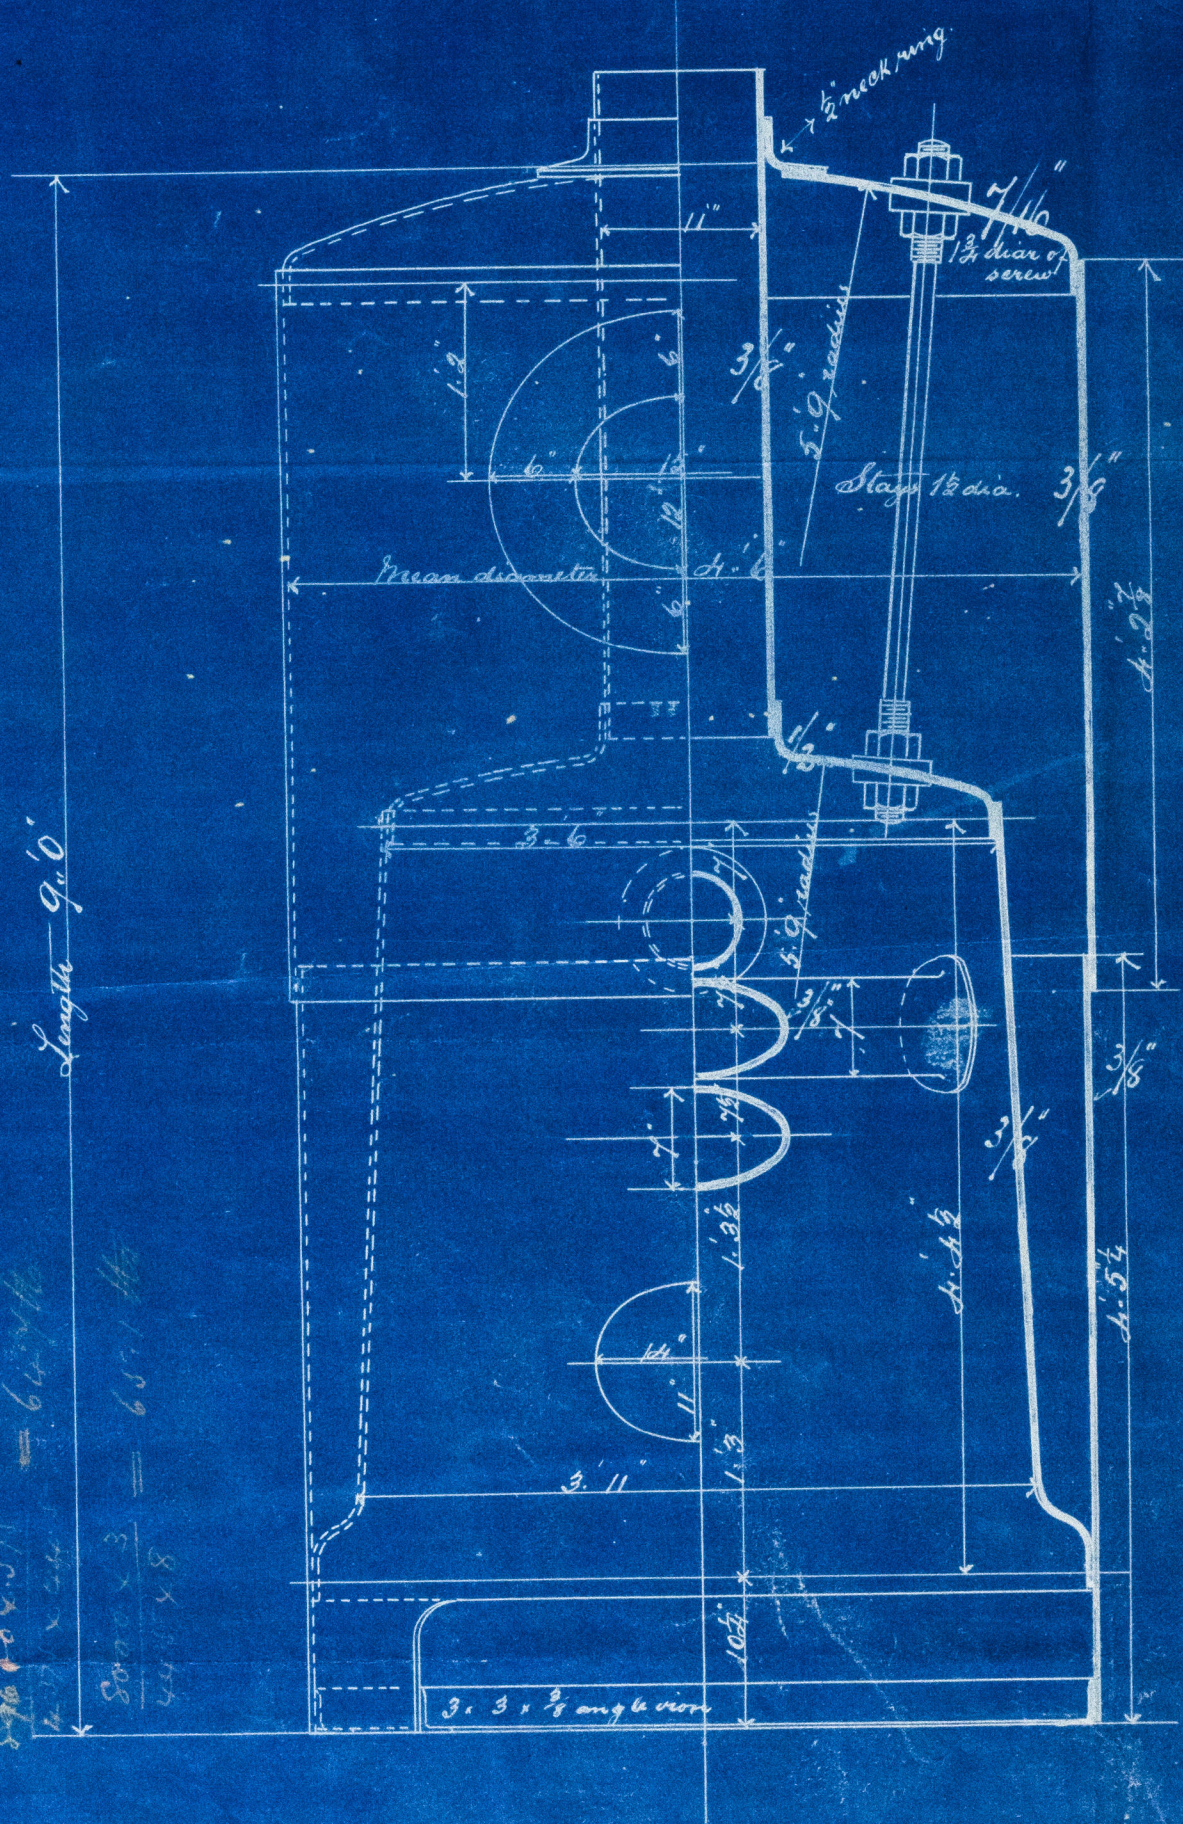

No. 402.  
THOMAS SUDRON & Co., Limited  
IMPERIAL BOILER WORKS,  
STOCKTON-ON-TEES.  
Hall Report No. 8344

HAND-HOLE AT ONE END OF EACH CROSS-TUBE

3 MUD-HOLES ROUND BASE

W.R.H.  
1st June 1891

Shell 200 x 10.0 x 1/4 = 94.0 lbs  
54 x 5  
Furnace 80 x 10 x 1/4 = 64.0 lbs  
4.0 x 5  
8000 x 3 = 65.1 lbs  
44.0 x 8

Circular Stems Single rivetted 13 Rivets 2 1/2 plates  
Vertical double 16 2 3/4  
Working Pressure 60 lbs per square inch

23/5/91

R



Charles S. By 67 KT:  
S. S. Gomez II.

Cotto per ex: m. app.

Hull Report No: 8344

HVL 406-0408



© 2019

Lloyd's Register  
Foundation