

10.2.93


Nos 371 & 372 s/s Swallow Hall Report No: 8648
 s/s Thrush — — — 8654

Midship Section

Dimensions per rule $92.5 \times 20' \times 12.08$ Scale $\frac{1}{2}'' = \text{one foot}$


Class 100 air iron

Half Breadth	10.0	10.0
Girth	18.20	18.20
Depth	12.25	12.25
	<u>40.45</u> - No	40.45
	<u>92.5</u>	<u>92.5</u>
	<u>3722.2</u> - No	<u>3741</u>

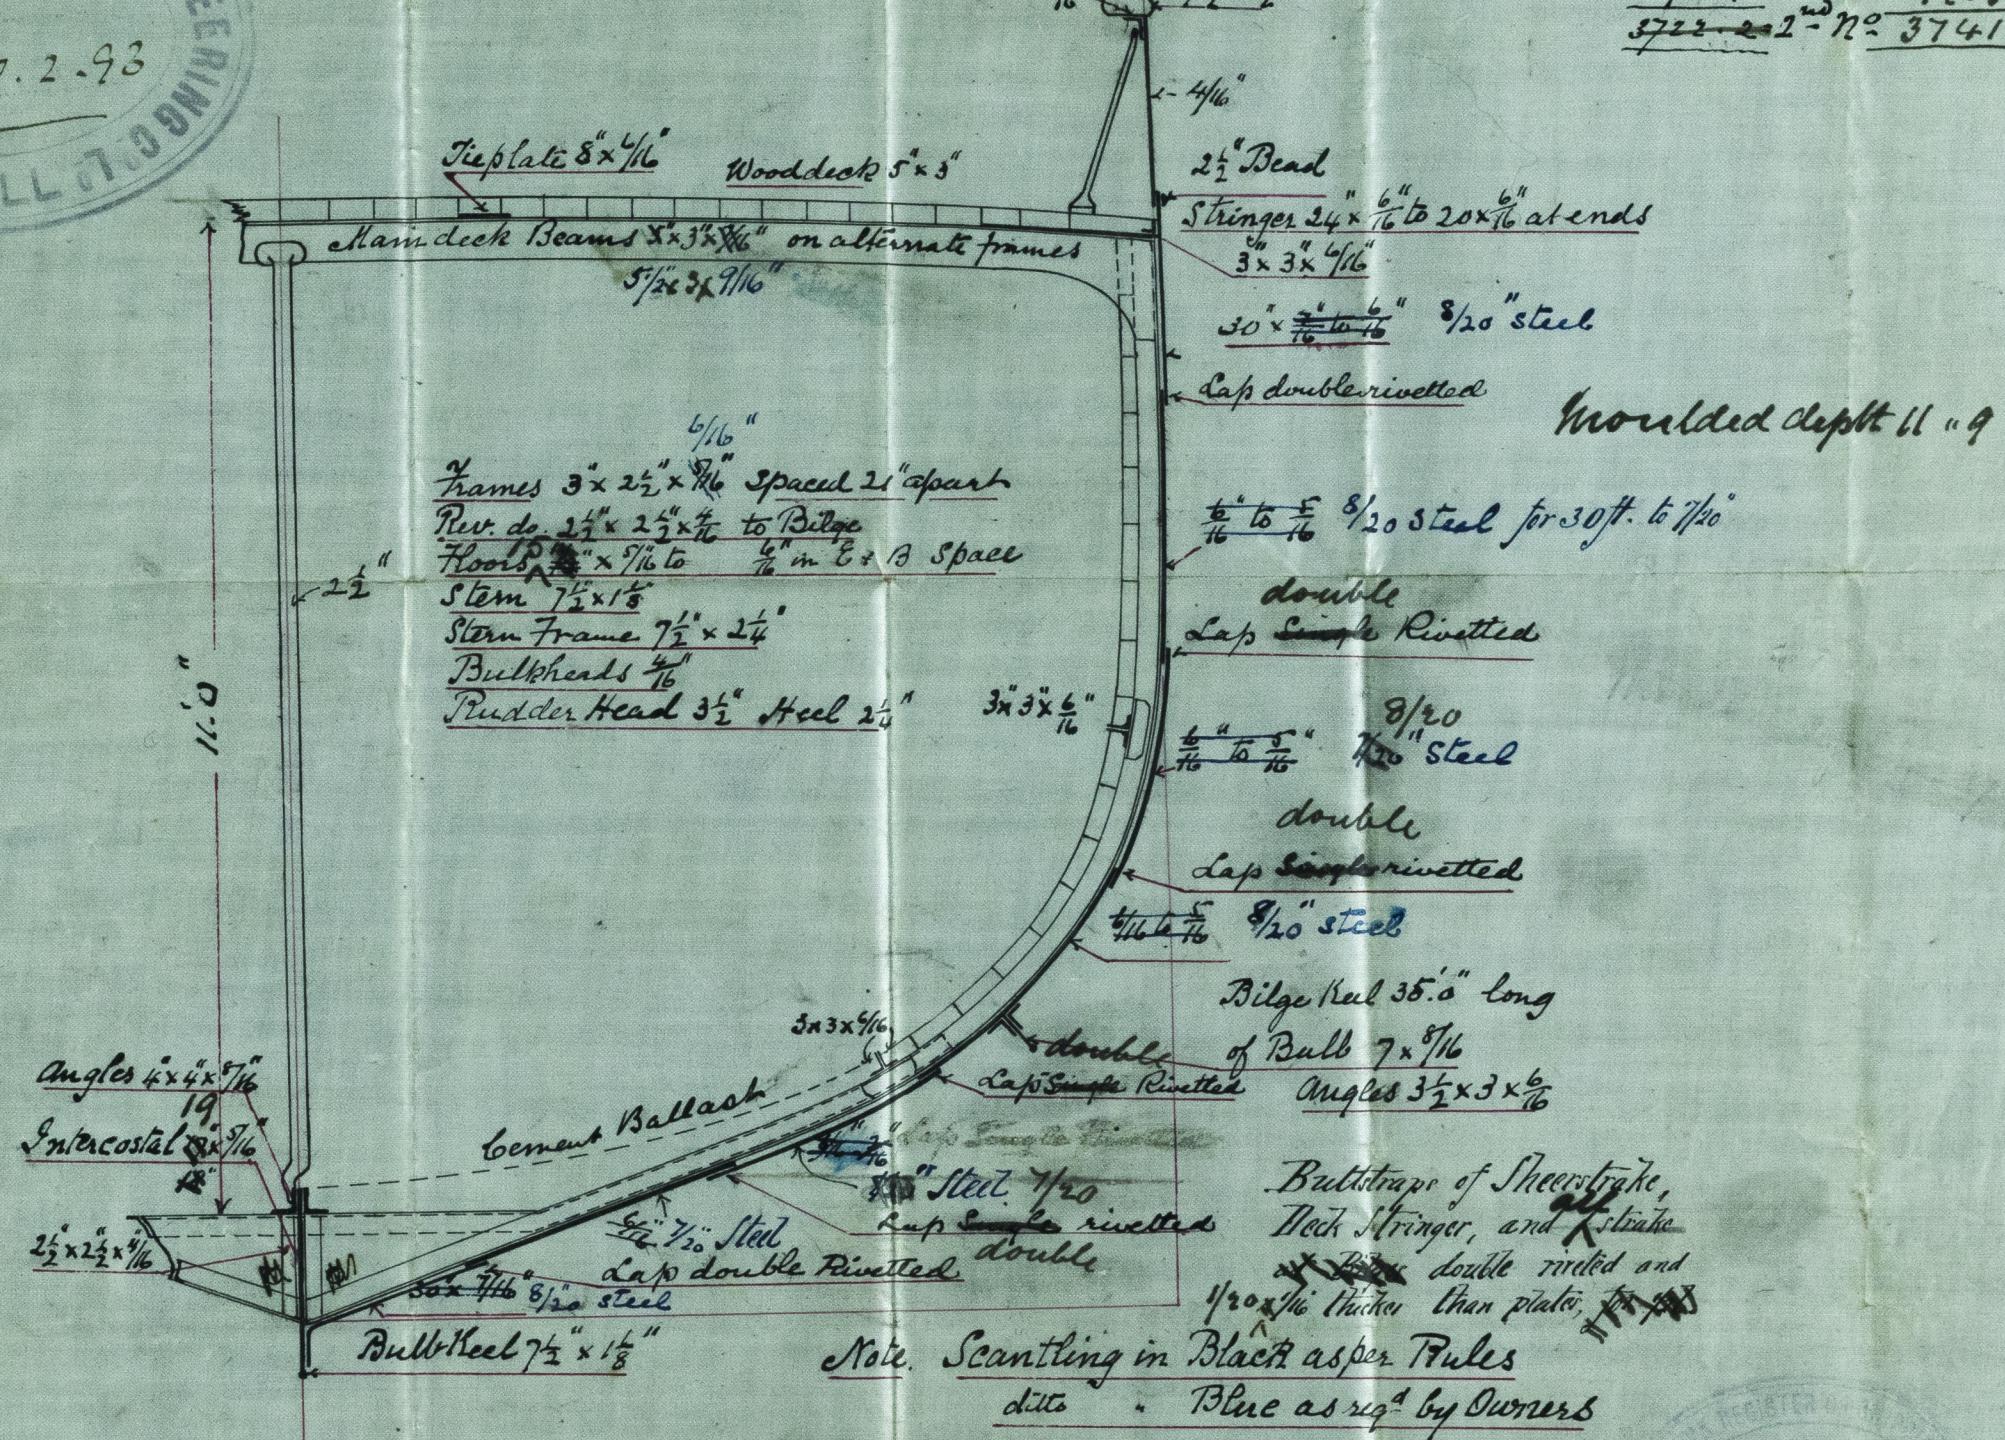

s/s Swallow
Hull Report No: 8648

s/s Thrush
Hull Report No: 8654

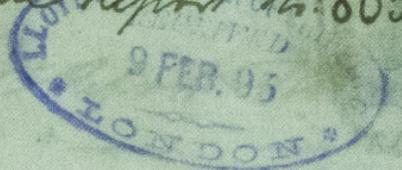

HULL407-0243

© 2019

Lloyd's Register
Foundation

