

10.7.93




S/S Swallow Hull Report No 8648
S/S Thrush - - - 8654

Nos 371 & 2.

Longitudinal Section showing Arrangement of Beams, Pillars &c.

Dimensions per rule 92.5 x 20. x 12.08

Scale $\frac{1}{4}$ " = 1 foot

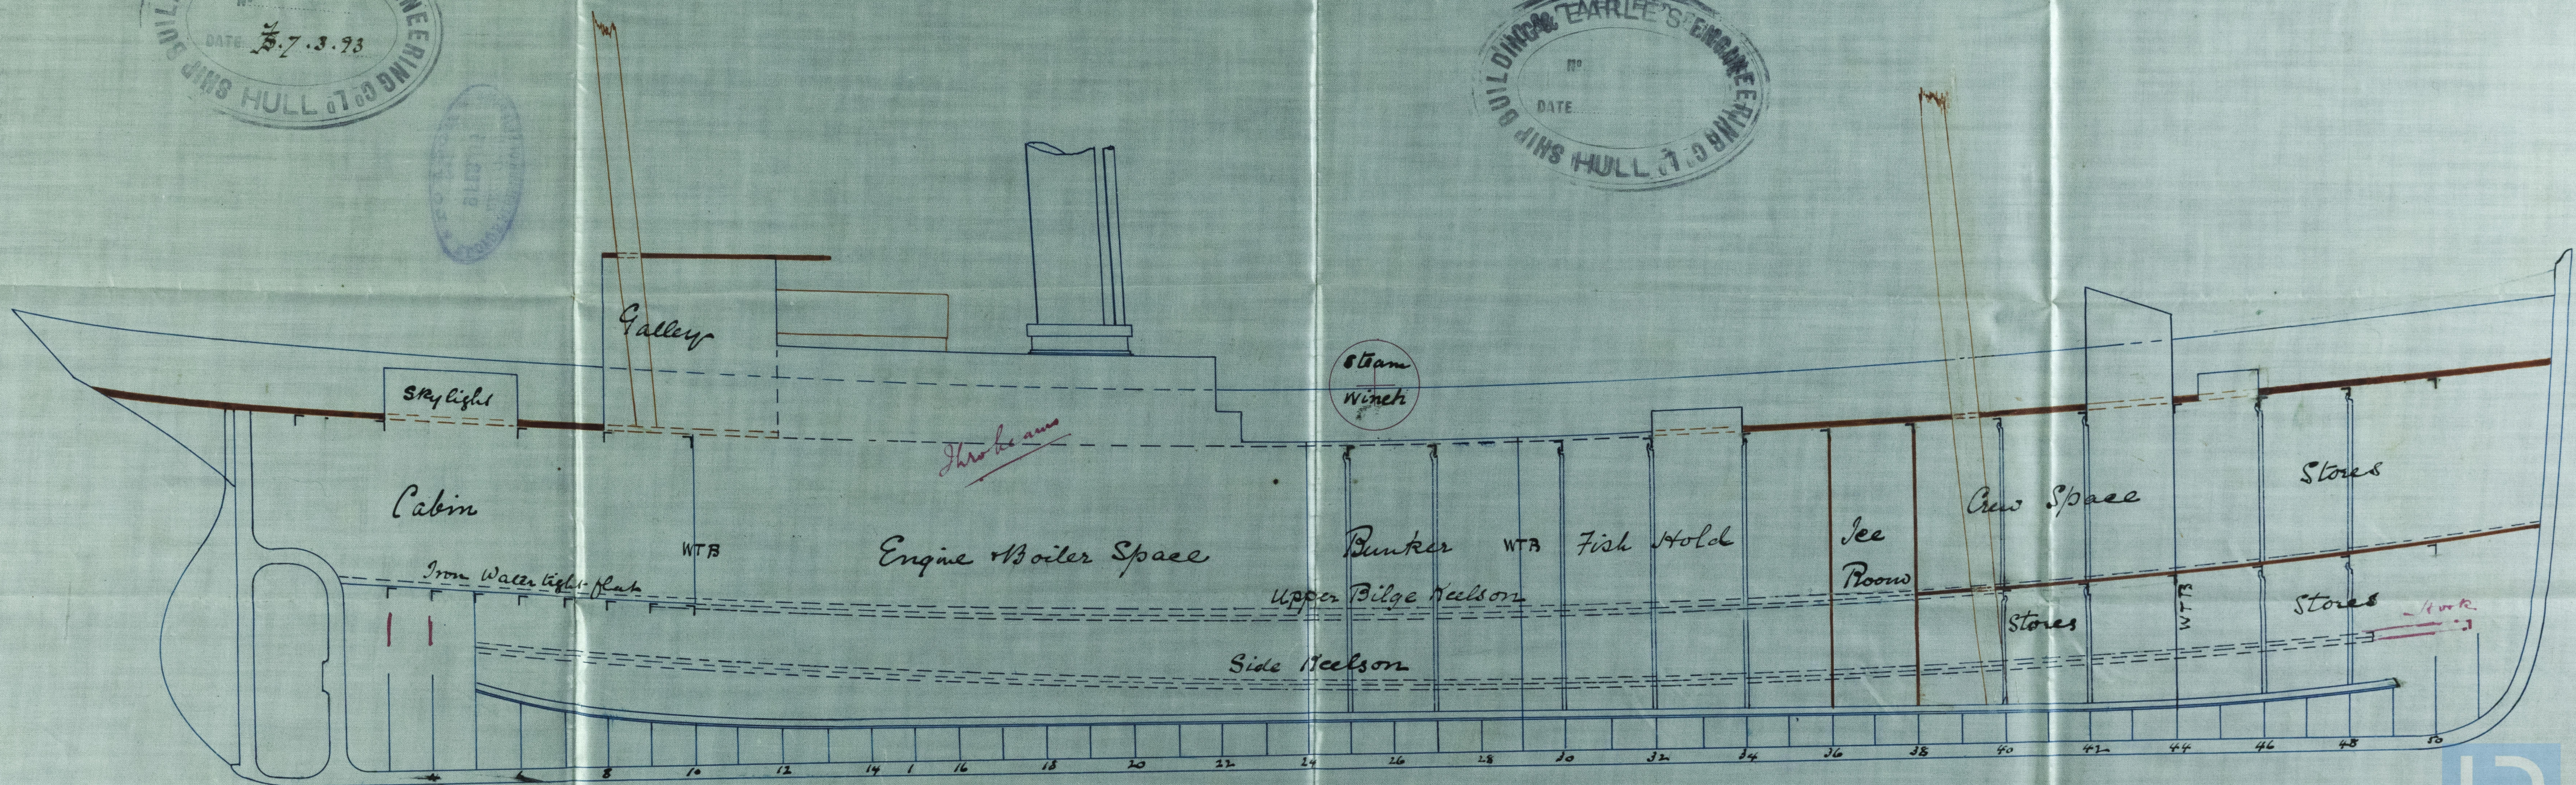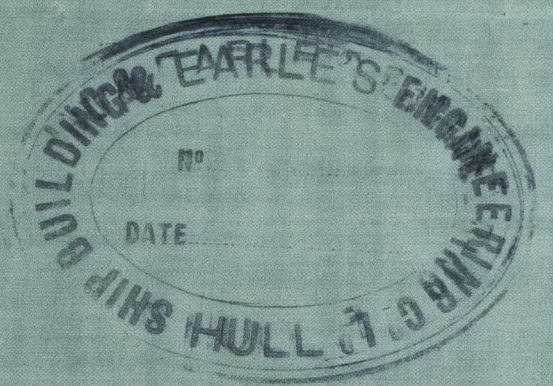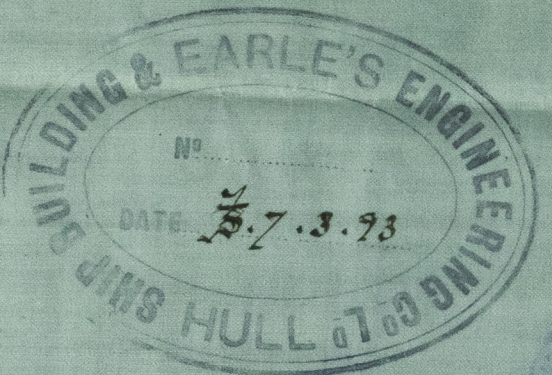

© 2019 Lloyd's Register Foundation
HULL 607-0245

S/s Swallow

Hull Report No: 8648

S/s Thrush

Hull Report No: 8654

HULL407-0245

2/10/95
E.P. L. 7.1

© 2019

Lloyd's Register
Foundation

