

27.4.93

s/s Rhine Hull Report No.

MIDSHIP SECTION S.S. N° 86

87.0 x 20.0 x 10.8 HOLD

SCALE 1/2" = ONE FOOT

CLASS 100.A1



- Length as per rule 85.9
- Half M. Breadth 10.0
- Depth Keel to M.D.K. Beams 11.10

1/2 Girth 17.25

1/2 Breadth 10.0

Depth 11.83

1st N° 39.08

65.45

195.40

243.56


195.40

312.64

2nd N° 351.1100


Round of Beam 6

- Beams on every alternate frame 5" x 3" x 9/16
- Frames 3 x 2 1/2 x 6/16 spaced 21" apart
- New do 2 1/2 x 2 1/2 x 7/16 up to deck & above
- Bilge Stringer alternately
- Floors 16 x 7/16 & 6/16 in E & B space
- Bulkheads 4/16
- Keel & Stern 7/12 x 1 1/8
- Stern post 7/12 x 2 1/4
- Rudder Head 3/12 Steel 2 1/4

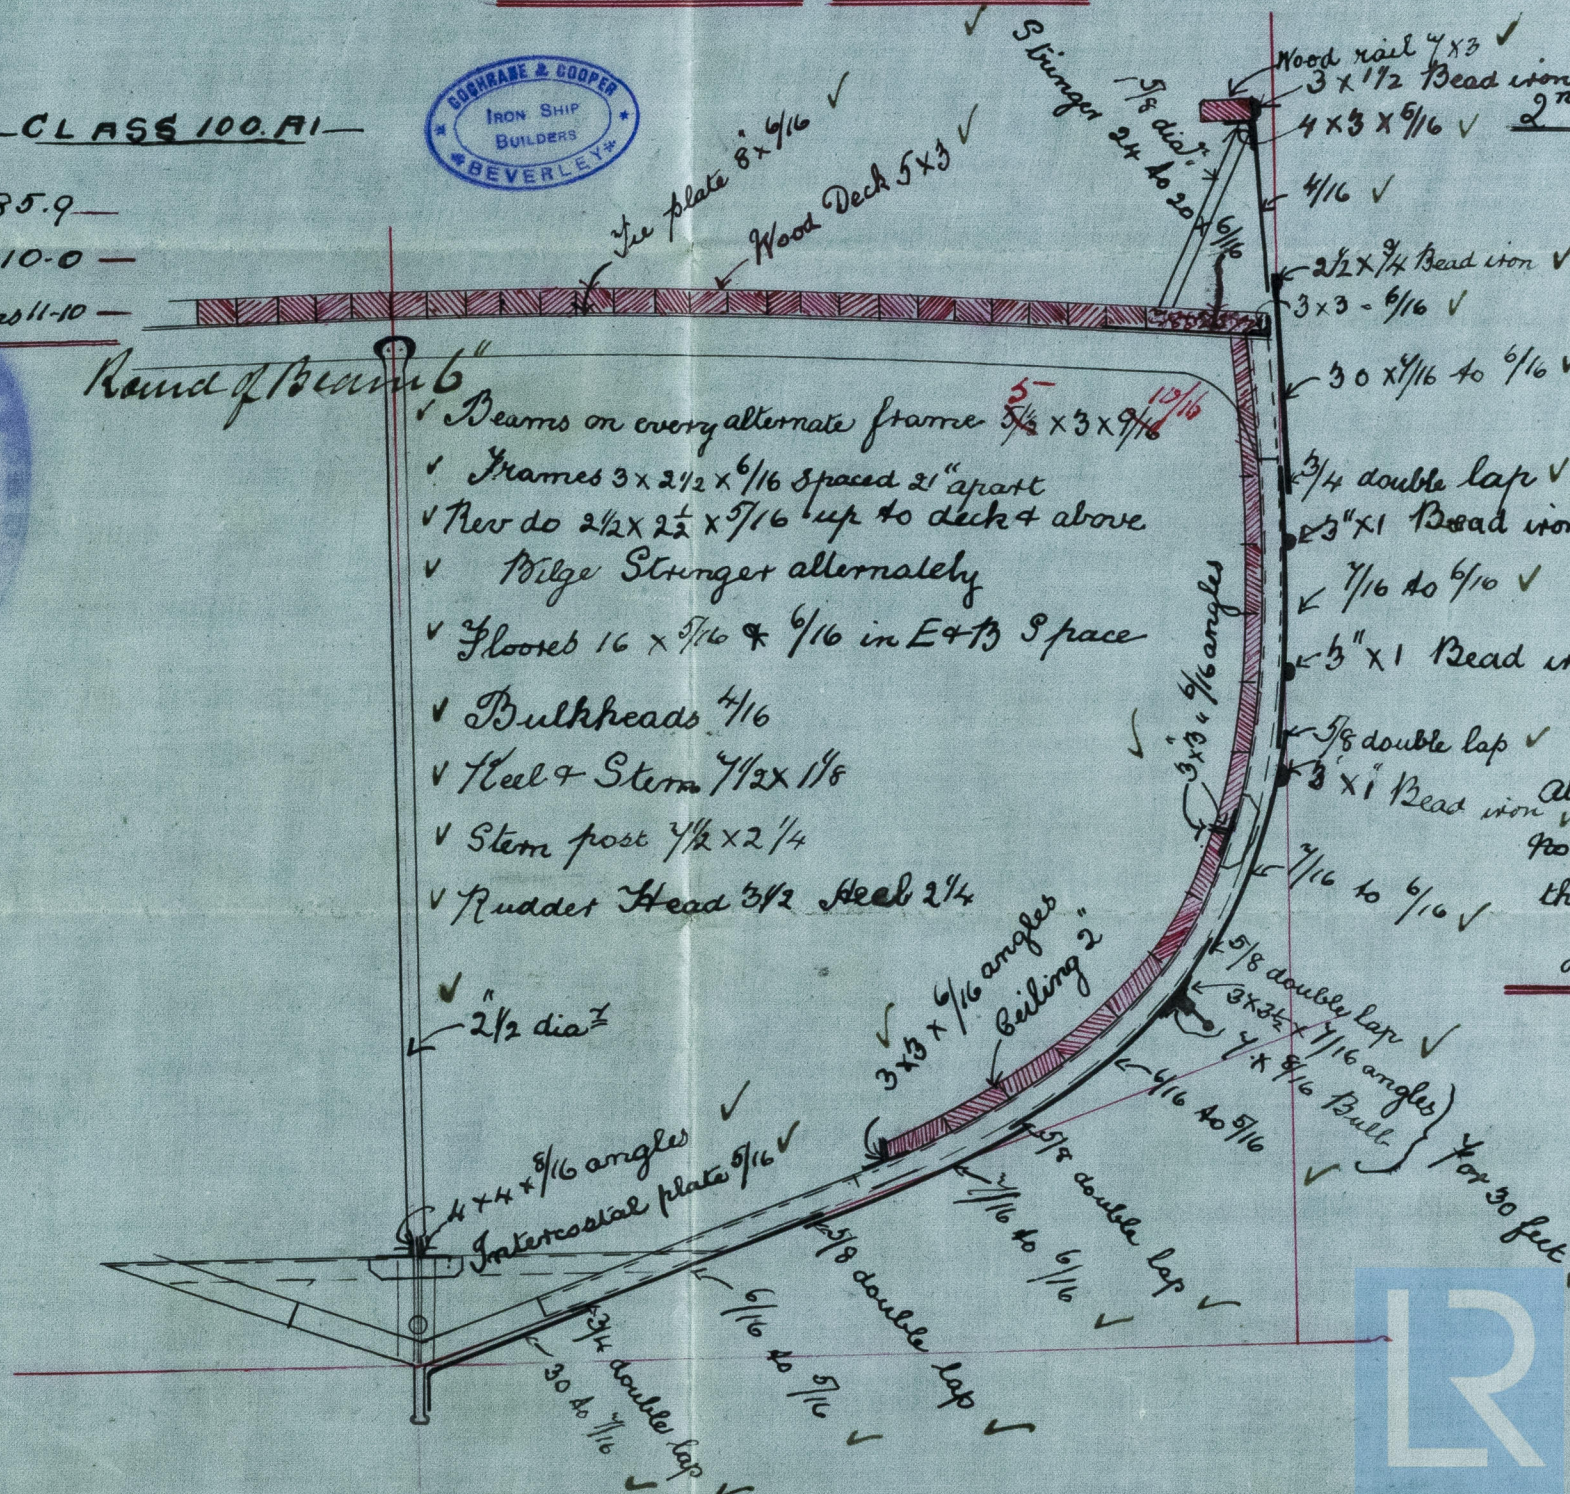

Moulded depth 11" 4"


All Butt Straps to be 7/16 thicker than the plates they connect & all double rivetted

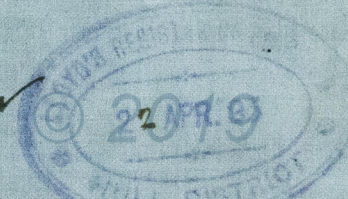

Lloyd's Register Foundation

MVL407-0328

s/s Rhine
Hull Rep. No: 8419.

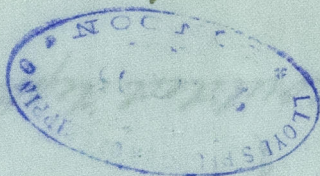

HVL 407-0328

© 2019

Lloyd's Register
Foundation