

Lloyd's Register of British and Foreign Shipping.

s/s Rhine
(Report on Vessel No. *8719* Port _____)



No. *1591* SHIP FORGINGS OR CASTINGS.

The words FORGINGS or CASTINGS, IRON or STEEL, should be struck out as may be required.

I have to report that the undermentioned Iron ~~or Steel~~ Forgings ~~or Castings~~, manufactured by *Messrs J March & Co* of *Dunston* for the Vessel No. *86*, being built by *Coehran Cooper & Co* of *Hull* have been inspected by me as set forth below, and found to be, so far as can be seen, *sound*


Mark on Forgings.

Lloyd's
No. *2549B*
JG

John C Craig
Newcastle
1/7/93

	STERN FRAME.	RUDDER FRAME.	STEM.
Material*	<i>Scrap Iron</i>	<i>Scrap Iron</i>	/
How made	<i>Forged</i>	<i>Forged</i>	
Dimensions	<i>7 1/2 - 2 1/4</i>	<i>3 1/2 - 2 1/4</i>	
Progress on Inspection	<i>Forged & Smothered</i>	<i>Forged & Smothered</i>	
Dates when Inspected	<i>May 4-8/93</i>	<i>May 11-26 June 6/93</i>	

SKETCHES OF FRAMES SHOWING POSITION AND DESCRIPTION OF WELDS OF FORGINGS, OR PARTICULARS OF TESTS APPLIED TO CASTINGS.

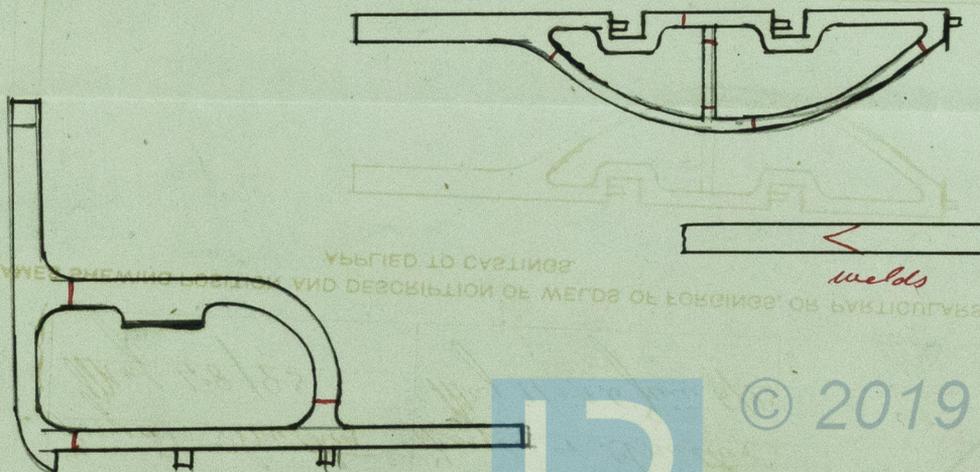

Dates when inspected
Progress on inspection
Dimensions
How made



© 2019

Lloyd's Register
Foundation

* If of Iron, state whether scrap or puddled Iron.