

Lloyd's Register of British and Foreign Shipping.

^{3/5 Dunbar}
(Report on Vessel No. 8955 Port Hull ^{24/2/94})

No. 1896 SHIP FORGINGS OR CASTINGS.

The words FORGINGS or CASTINGS, IRON or STEEL, should be struck out as may be required.

I have to report that the undermentioned Iron ~~or Steel~~ Forgings ~~or Castings~~,
manufactured by Messrs J March & Co
of Dunston for the Vessel No. 102, being built
by Messrs Cochran & Cooper & Co of Hull
have been inspected by me as set forth below, and found to be, so far as can be seen,
Sound



Mark on Forgings.

Lloyd's
No. 3184B
86

John B Craig
Newcastle

	STERN FRAME.	RUDDER FRAME.	STEM.
Material* ...	<u>Scrap Iron</u>	<u>Scrap Iron</u>	/
How made ...	<u>Forged</u>	<u>Forged</u>	
Dimensions ...	<u>6 - 2 1/2</u>	<u>3 1/2 - 2 1/4</u>	
Progress on Inspection	<u>Forged & Smithed</u>	<u>Forged & Smithed</u>	
Date when Inspected	<u>December 8-18-27/93</u>	<u>January 10-29-31/94</u>	

SKETCHES OF FRAMES SHOWING POSITION AND DESCRIPTION OF WELDS OF FORGINGS, OR PARTICULARS OF TESTS APPLIED TO CASTINGS.

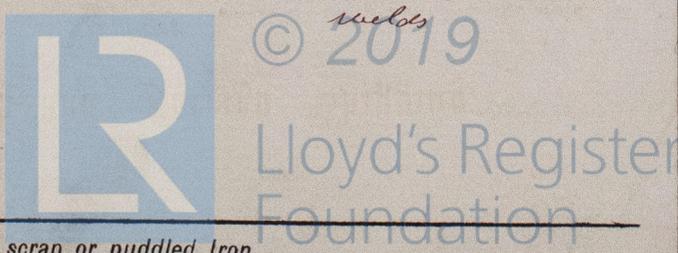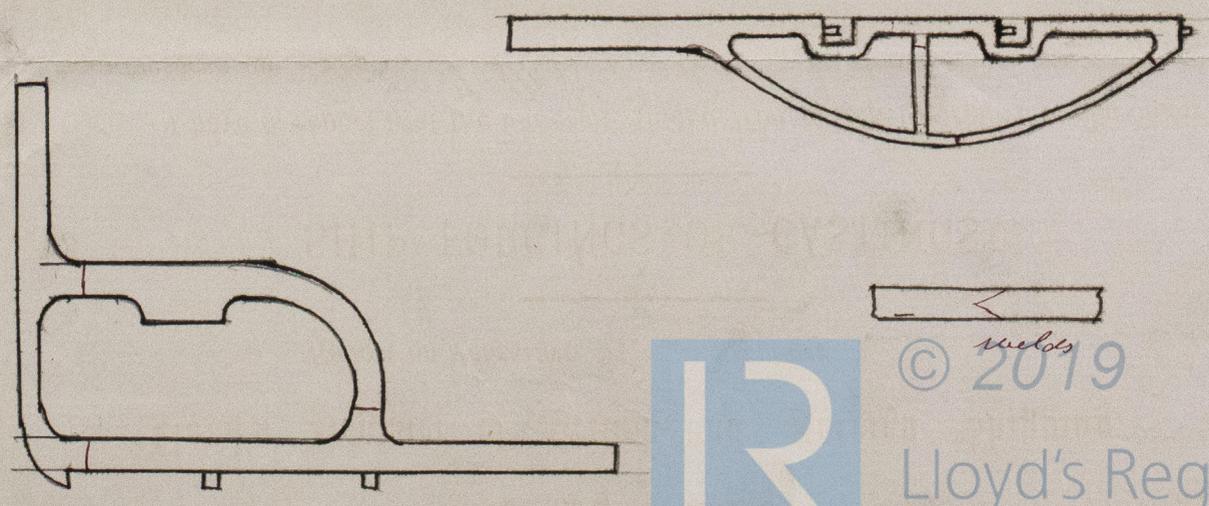

* If of Iron, state whether scrap or puddled Iron.