

Lloyd's Register of British and Foreign Shipping.

s/s Uganda
(Report on Vessel No. *9023* Port *Hull*)

19/5/94

No. *2040* SHIP FORGINGS OR CASTINGS.

The words FORGINGS or CASTINGS, IRON or STEEL, should be struck out as may be required.

I have to report that the undermentioned Iron ~~or Steel~~ Forgings ~~or Castings~~,
manufactured by *Messrs Emmerson Walker & Thompson*
of *Dunston* for the Vessel No. *120*, being built
by *Messrs Cook & Welton & Gemmell* of *Hull*
have been inspected by me as set forth below, and found to be, so far as can be seen,

Mark on Forgings.

Lloyd's


No. *33120*

JB

John C Craig
Newcastle

	STERN FRAME.	RUDDER FRAME.	STEM.
Material*	<i>Scrap Iron</i>	<i>Scrap Iron</i>	
How made	<i>Forged</i>	<i>Forged</i>	
Dimensions	<i>6-2 1/2</i>	<i>3 1/2 - 2 1/4</i>	
Progress on Inspection	<i>Forged & Smithed</i>	<i>Forged & Smithed</i>	
Date when Inspected	<i>February 26 March 1-6-14/94</i>	<i>April 10-18-26/94</i>	

SKETCHES OF FRAMES SHOWING POSITION AND DESCRIPTION OF WELDS OF FORGINGS, OR PARTICULARS OF TESTS APPLIED TO CASTINGS.

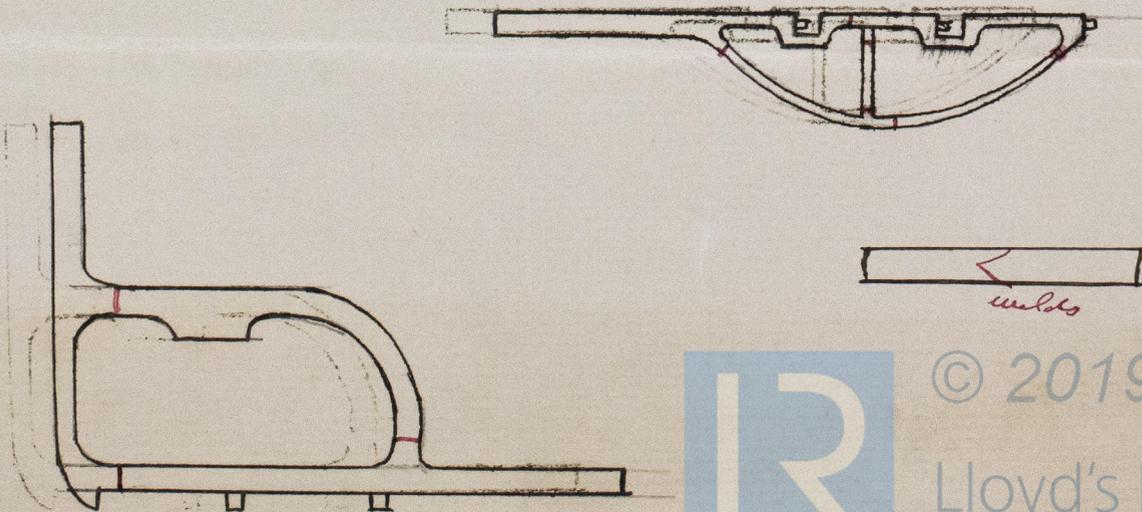

© 2019

Lloyd's Register
Foundation

* If of Iron, state whether scrap or puddled Iron.