

s/s Cuckoo

Have Report No 9059

HUL408-0339



© 2019

Lloyd's Register
Foundation


s/s Cuckoo
Hull Report No 9059

No 386.

SKETCH SHOWING
PROPOSED ALTERATION TO
SCREWED STAYS IN BACK
END OF BOILER.



DOUBLING PLATE
11/16" THICK.
RIVETED TO END PLATE.

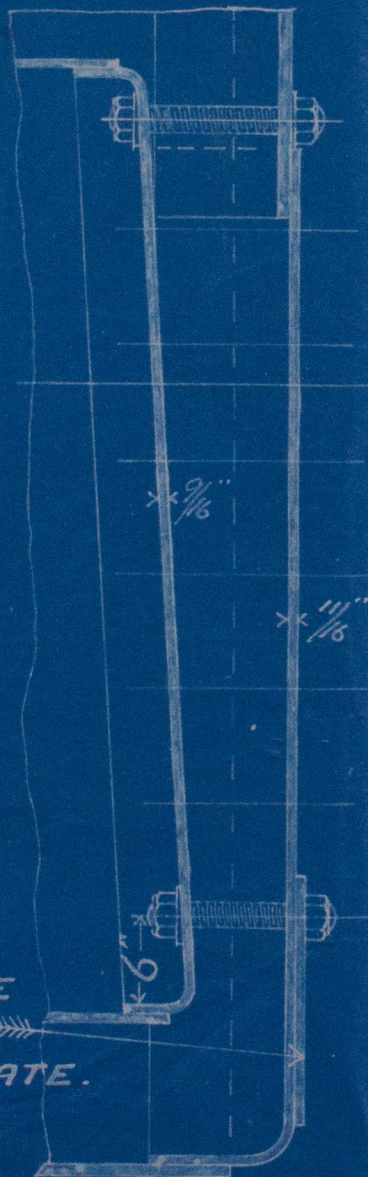

No 3680.
19.2.94

HUL408-0339