

Sps Case No 0
Hull Report No:

LOYD'S REGISTER OF SHIPS
RECEIVED
19 JAN. 94

© 2019

Lloyd's Register
Foundation

22. 1. 94.

— No. 386 —

Scale $\frac{1}{2}'' = \text{one ft.}$

Midship Section

Dimensions per Rule.
92.25' x 20.5' x 11.833'

Class 100 A. Iron with Steel Shell

Half Breadth. 10.25

Yerth. 18.90

Half Depth. 11.833

40.983 - 1.4


92.25

204915
81966

81966.

36 884 /

3780.681/5 2.00.

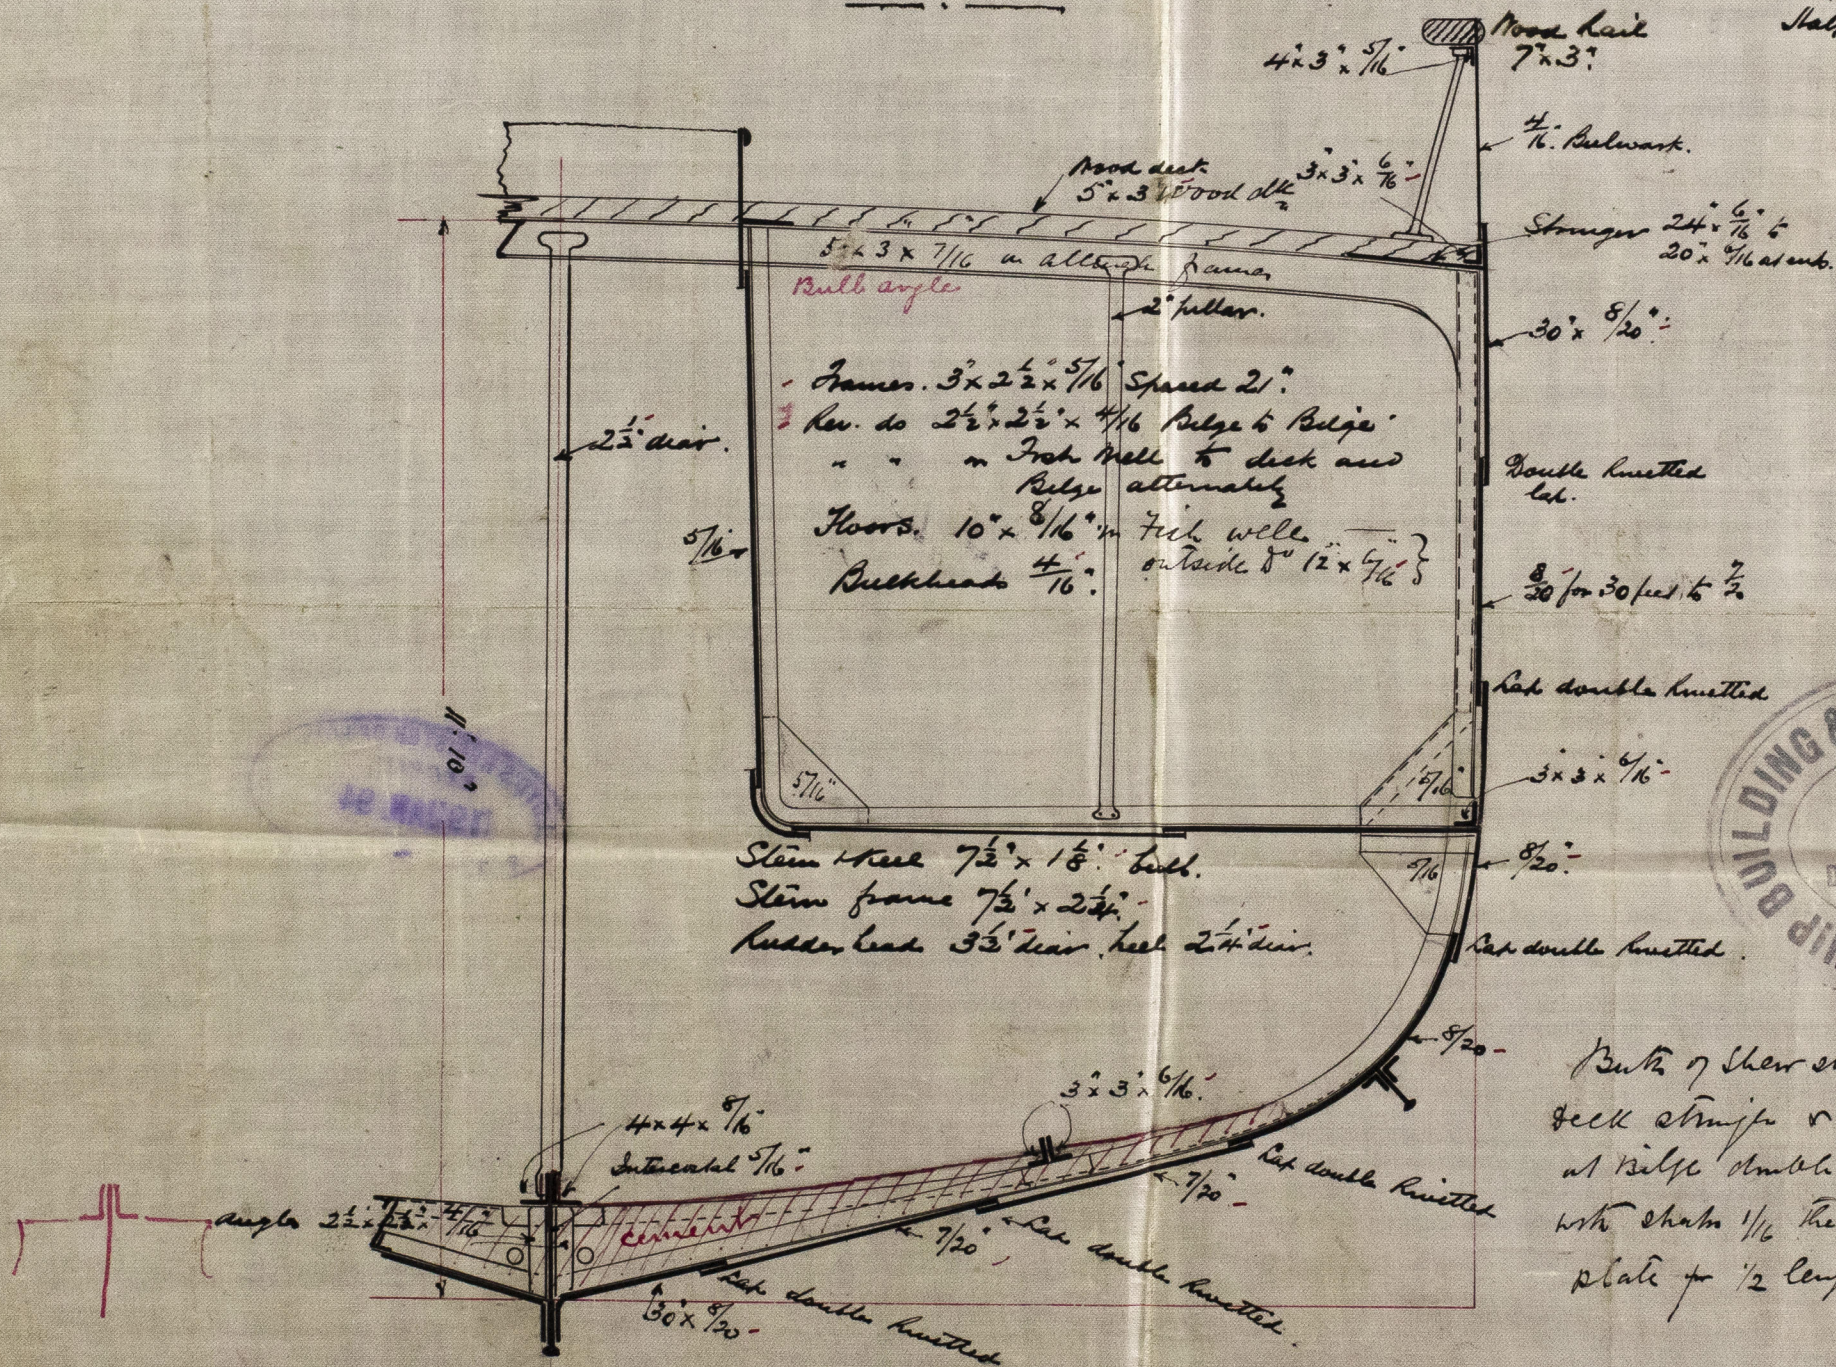


Butts of Shew Shale
beek strips or 1 Shale
at ridge double rivelled
with Shale $\frac{1}{16}$ thicker than
plate for $\frac{1}{2}$ length.

Section of Centre Nelson thro
Fish well

$3 \times 3 \times \frac{9}{16}$ $112 \times \frac{8}{16}$

present

 $2\frac{1}{2} \times 2\frac{1}{2} = 4\frac{1}{4}$ 

8 JAN 24

© 2019

Lloyd's Register
Foundation

HVL408-0340