

of Lucko

House Report No.

1838

Michigan Section

Dimensions for the 22.25 x 20.25 x 11.833

Class 00 A down with steel shell


Steel shell 10.22
Steel 18.90

11.833
40.983-1.833
39.150
30.4913
81.966
81.966
36841
3480.6812-2.25

Measured depth 11.4

Double riveted
Gap
1/2" for 20 ft. x 400.

Double riveted
Gap

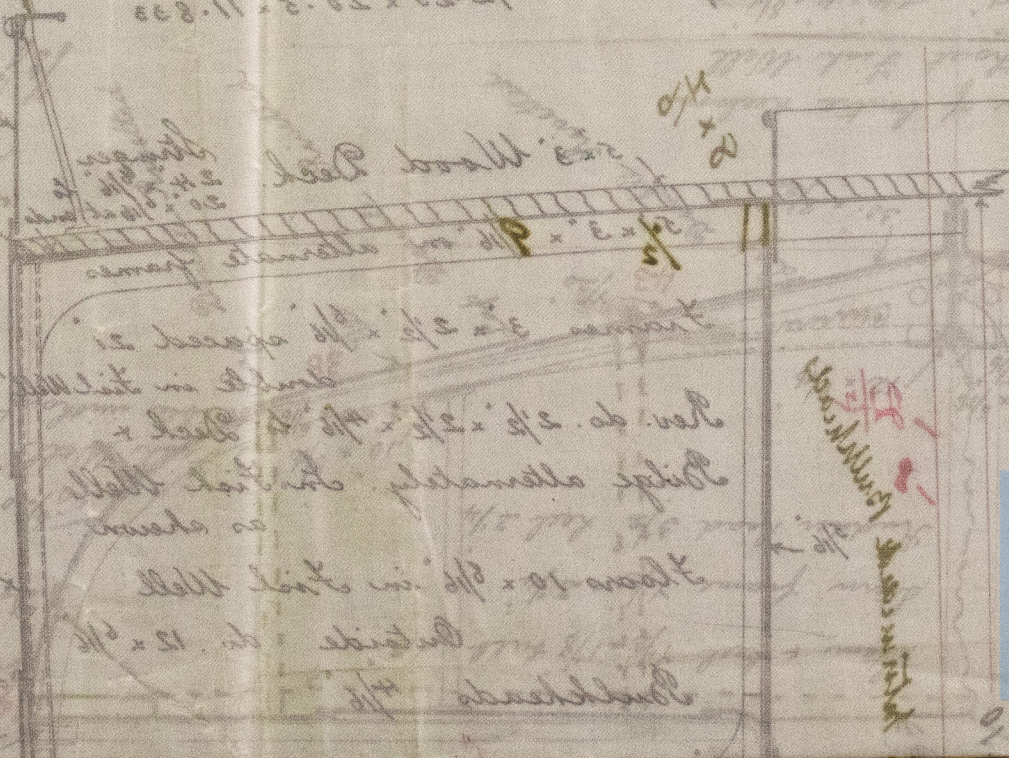

© 2019

Lloyd's Register
Foundation

