

HUL408-0348

s/s Chantrelle
Hull Report No: 9072



© 2019


Lloyd's Register
Foundation

12.3.94

BEAM ARRANGEMENT S S No 122

Scale 1/4" = one foot

S/S Charterer
Hull Report No: 9072.

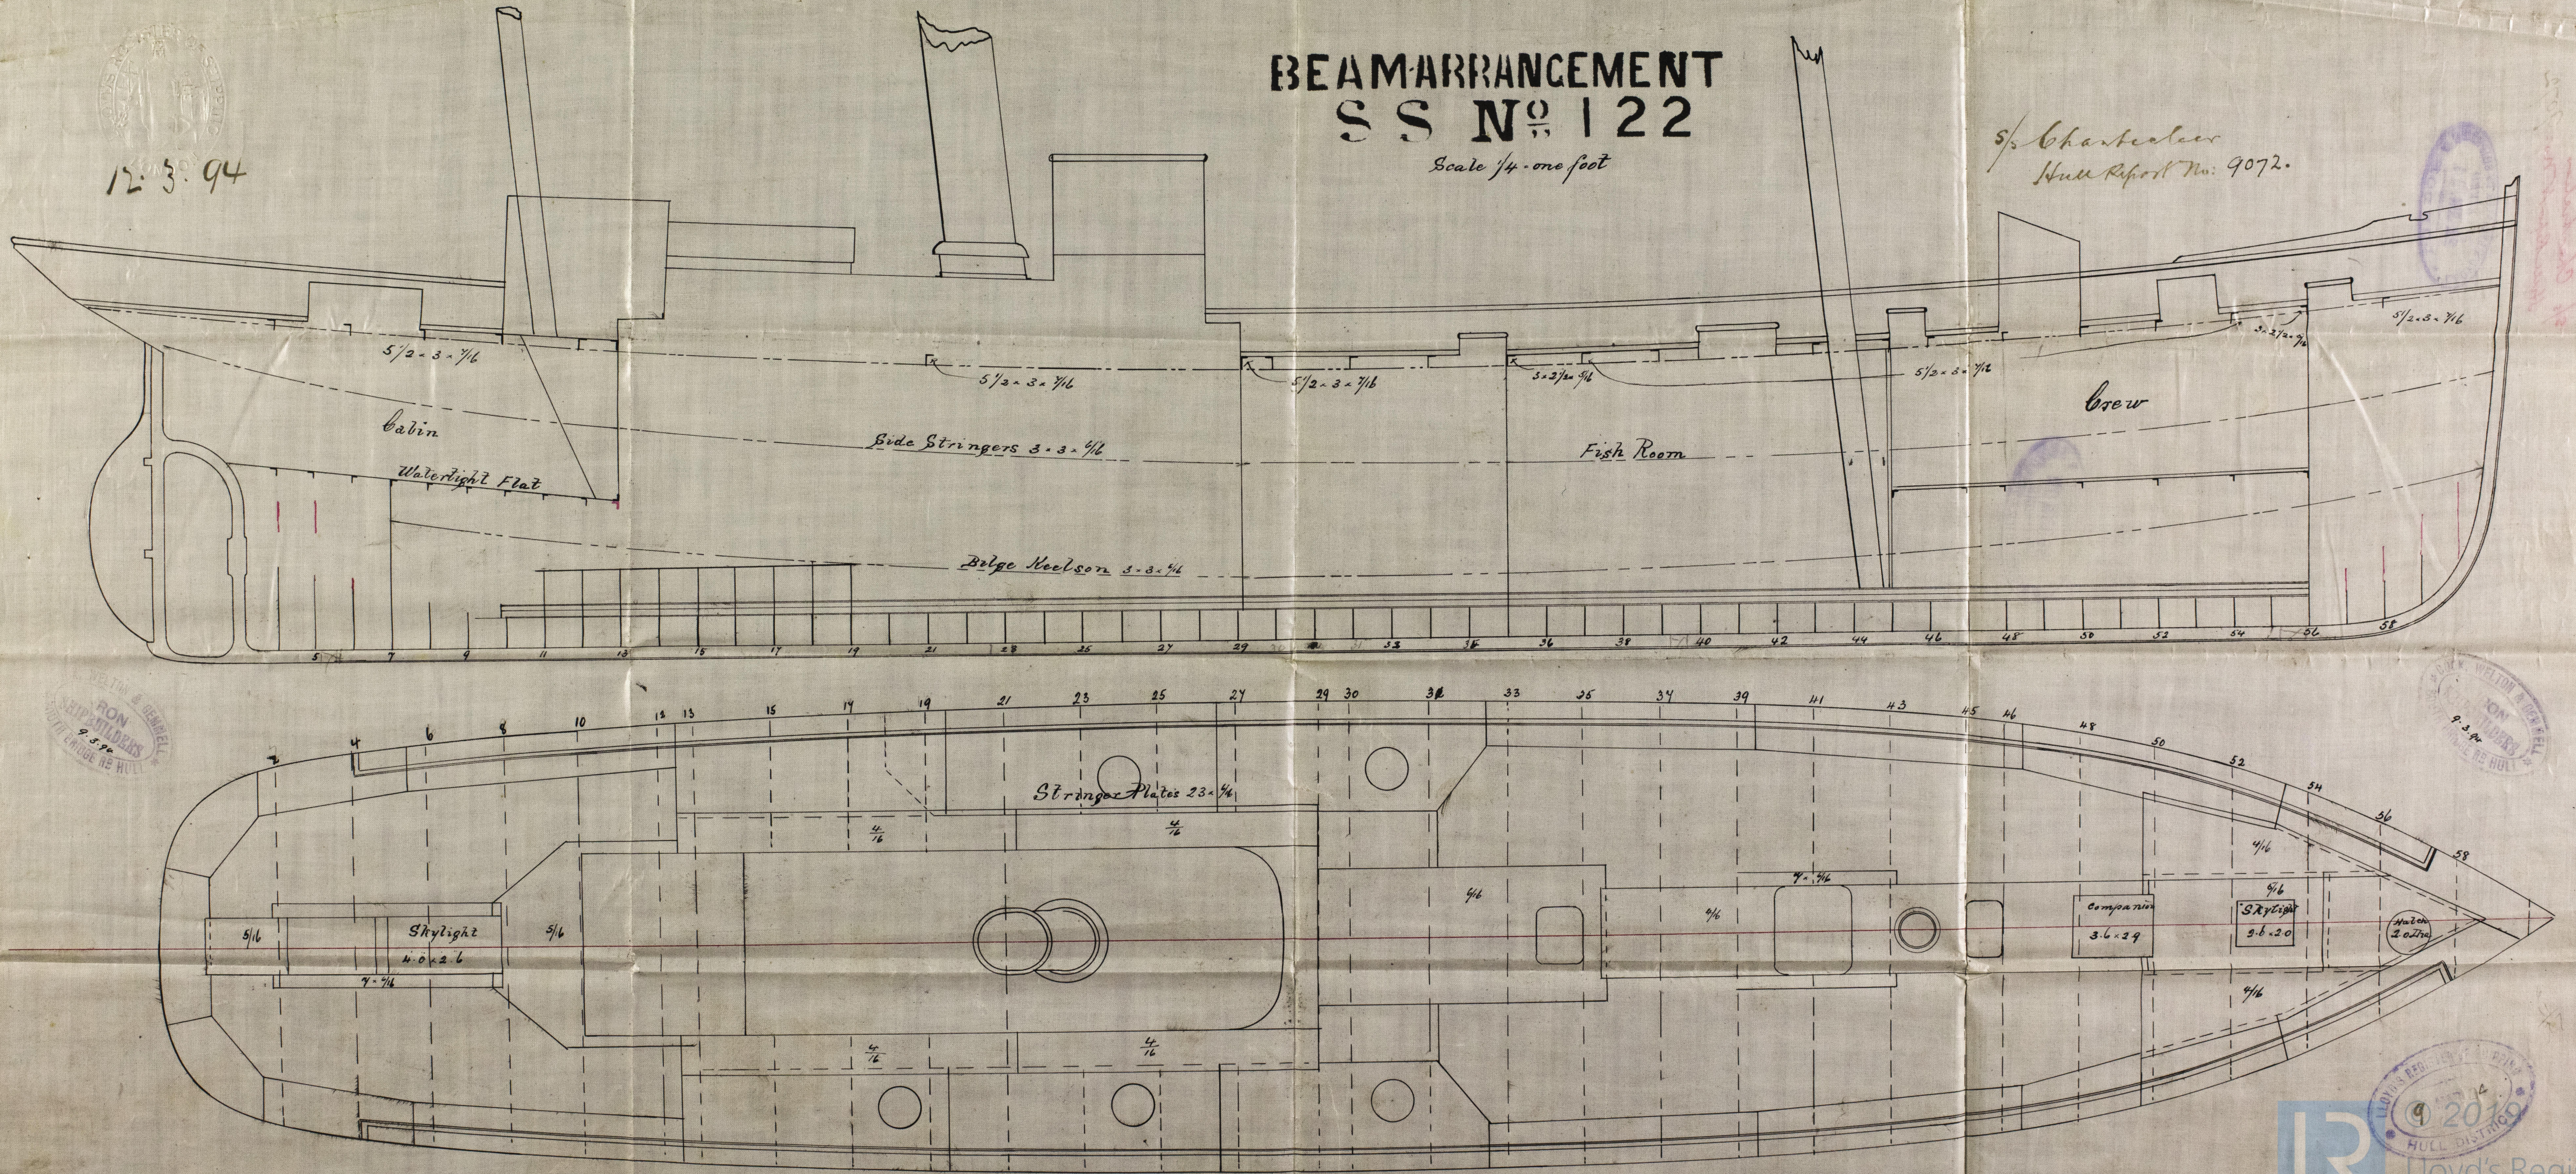

WELTON & GEMMELL
SHIPBUILDERS
2, 5, 9, 11
WORTH LANE RE HULL

WELTON & GEMMELL
SHIPBUILDERS
2, 5, 9, 11
WORTH LANE RE HULL

Lloyd's Register
HULL DISTRICT
2019
HULL 408-0348
Foundation

17/12/94