

## Lloyd's Register of British and Foreign Shipping.

(Report on Vessel No. 9072 Port Hull 21/6/94)No. 2118

## SHIP FORGINGS OR CASTINGS.

I have to report that the undermentioned Iron ~~or Steel~~ Forgings ~~or Castings~~,  
 manufactured by Messrs. Emmerson Walker & Thompson  
 of Dunston for the Vessel No. 122, being built  
 by Messrs. Cook, Wotton & Ginnell of Hull  
 have been inspected by me as set forth below, and found to be, so far as can be seen,  
Sound

Mark on Forgings.




Lloyd's

No. 35725  
86

John B Craig  
Newcastle

	STERN FRAME.	RUDDER FRAME.	STEM.
Material*	<u>Scrap Iron</u>	<u>Scrap Iron</u>	
How made	<u>Forged</u>	<u>Forged</u>	
Dimensions	<u>6 - 2 1/2</u>	<u>3 1/2 - 2</u>	
Progress on Inspection	<u>Forged &amp; Smutted</u>	<u>Forged &amp; Smutted</u>	
Date when Inspected	<u>April 4-10-12/94</u>	<u>May 17-20</u> <u>June 1/94</u>	

SKETCHES OF FRAMES SHOWING POSITION AND DESCRIPTION OF WELDS OF FORGINGS, OR PARTICULARS OF  
 TESTS APPLIED TO CASTINGS.

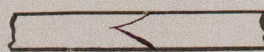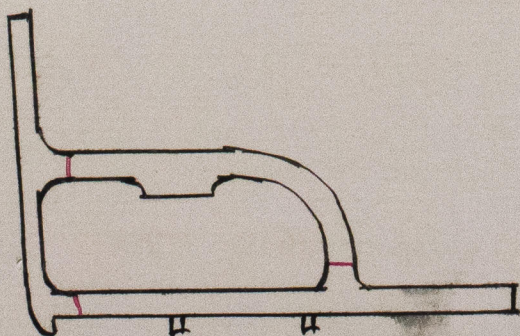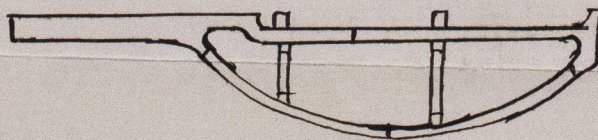

welds



© 2019

Lloyd's Register  
Foundation