

10. 3. 94


*s/p Riv*  
Hull Report No.

MIDSHIP SECTION S S N<sup>os</sup> 107  
- 87' 0" x 20' 0" x 10' 8" HOLD -  
SCALE 1/2" = ONE FOOT



- CLASS 100 A1 -

- Length as per rule 85'-9"
- Half M. Breadth 10'-0"
- Depth keel to M. Dk Beams 11'-10"

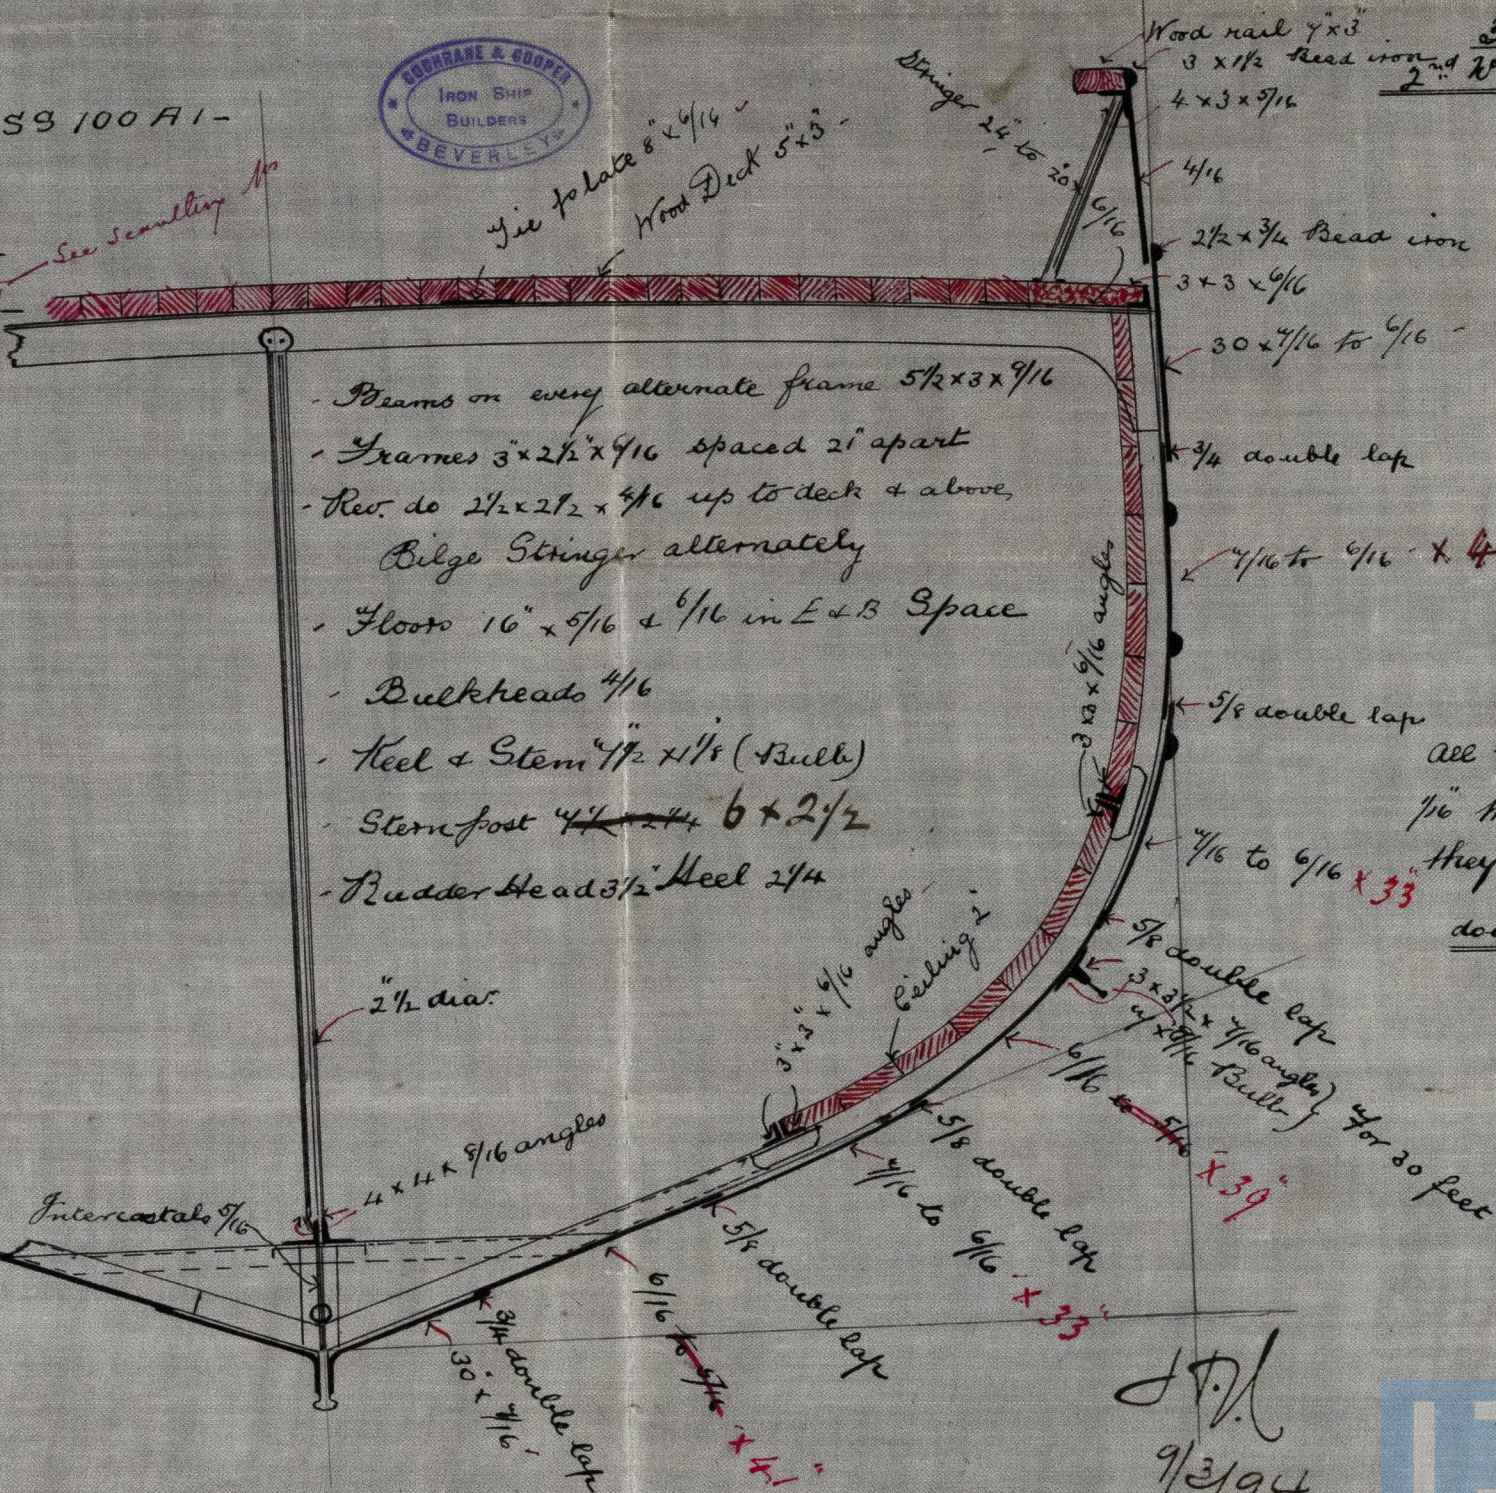

1/2 Girth 14.25  
1/2 Breadth 10.0  
Depth 11.83  
1420 39.08  
85.46  
195.40  
243.56  
195.40  
212.64  
2nd 23351.1100

$\frac{L}{D} = 7.2$

$\frac{L}{B} = 4.2$

Estimated depth 11'-5"



© 2019 Lloyd's Register  
HVL409-0040



