

MIDSHIP SECTION. S. T. N. 114.

16.5.94

Length as per rule 90' 10 1/2"
1/2 M. breadth 10' 2 1/2"
Depth Keel to MDB 12' 4"


Class 100 A

Raised Q² Deck 17' 6"

92' 0" x 20' 6" x 11' 0" HOLD.

Jacop.

Built Benley 1894

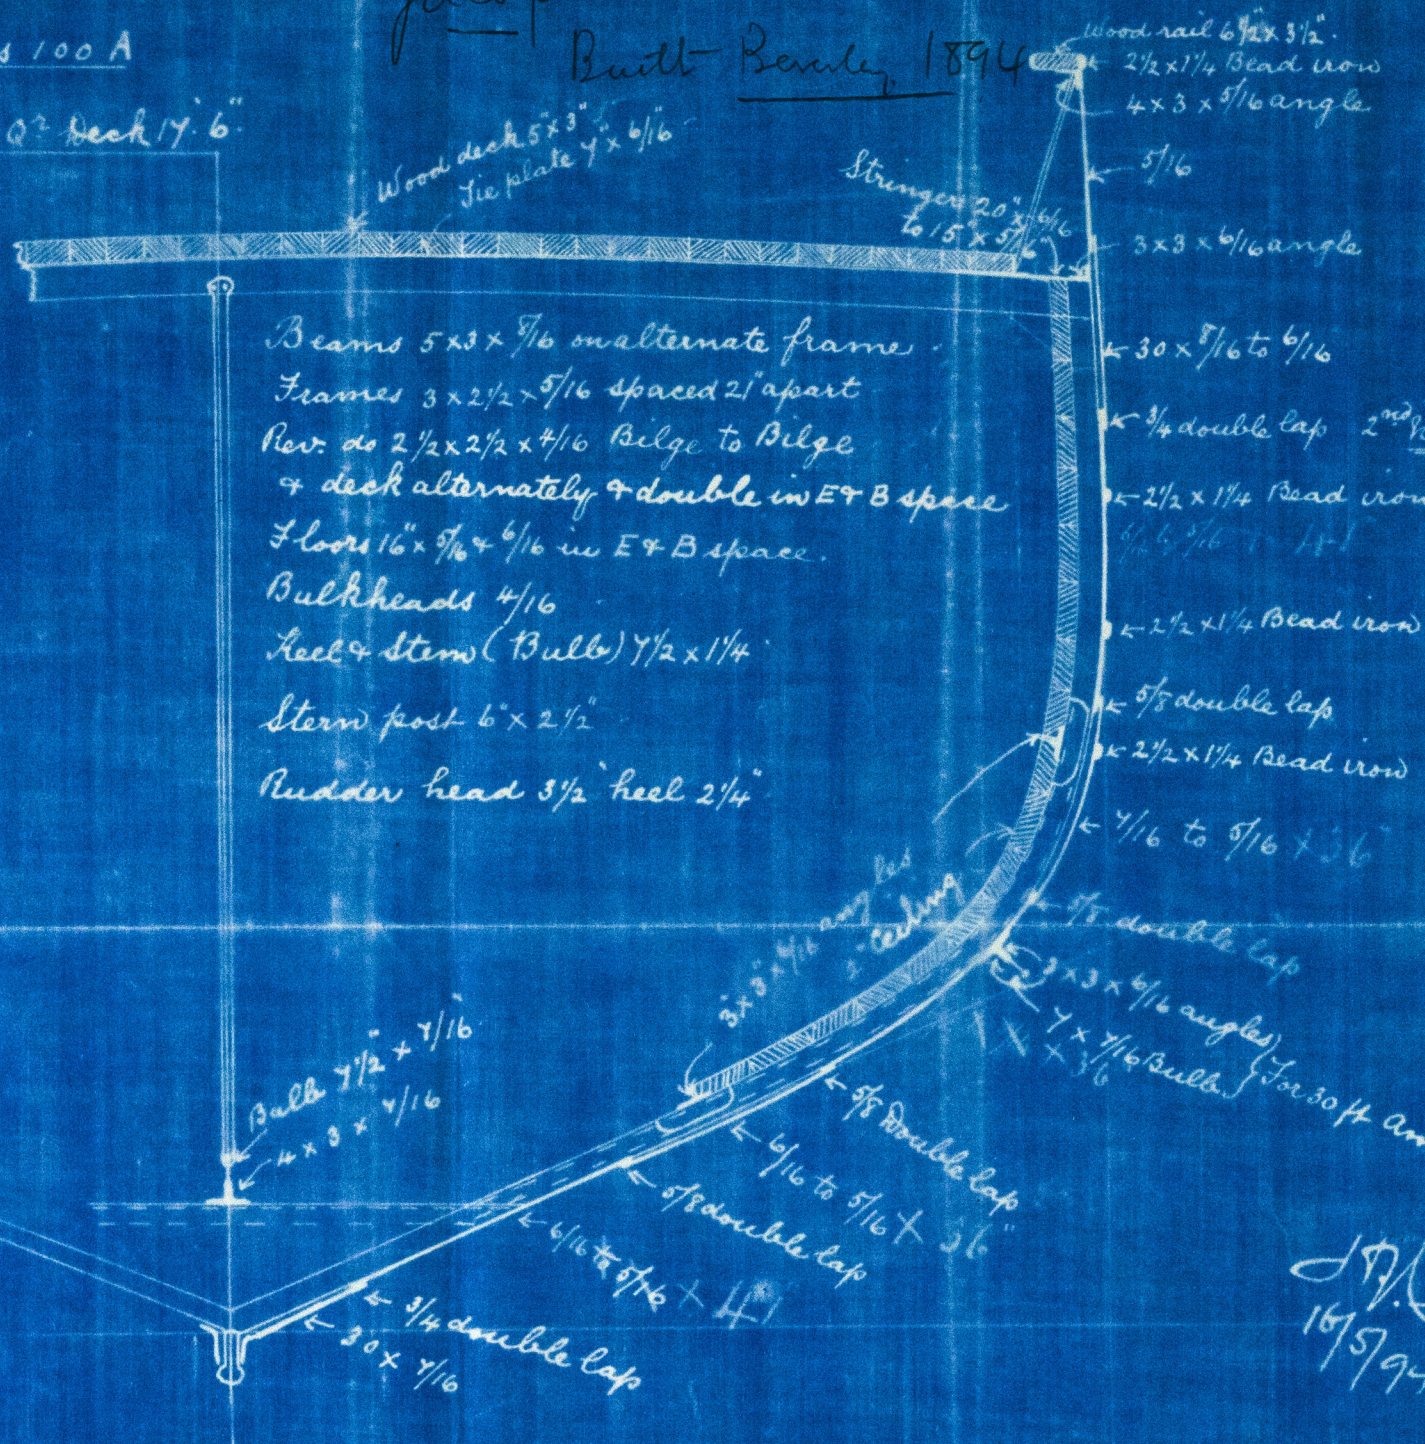

1/2 Girth 17.83
1/2 Breadth 10.20
Depth 12.33

1st No. 40.36
90.87

28 2 52

3 2 2 8 8

3 6 3 2 40

2nd No 3 6 6 7.5 1 3 2

all shell butt straps to be
1/16 thicker than plates
they connect.

J.H.L.
16/5/94

© 2019

Lloyd's Register

HUL404-0135