

MIDSHIP SECTION. S.T. N° 114.

s/o Northwood
Hull Report No


16.5.94

Length as per rule 90' 10 1/2"
1/2 m. breadth 10' 2 1/2"
Depth Keel to MDB 12' 4"

92' 0" x 20' 6" x 11' 0" HOLD.

Class 100 A

Raised Q² Deck 17' 6"

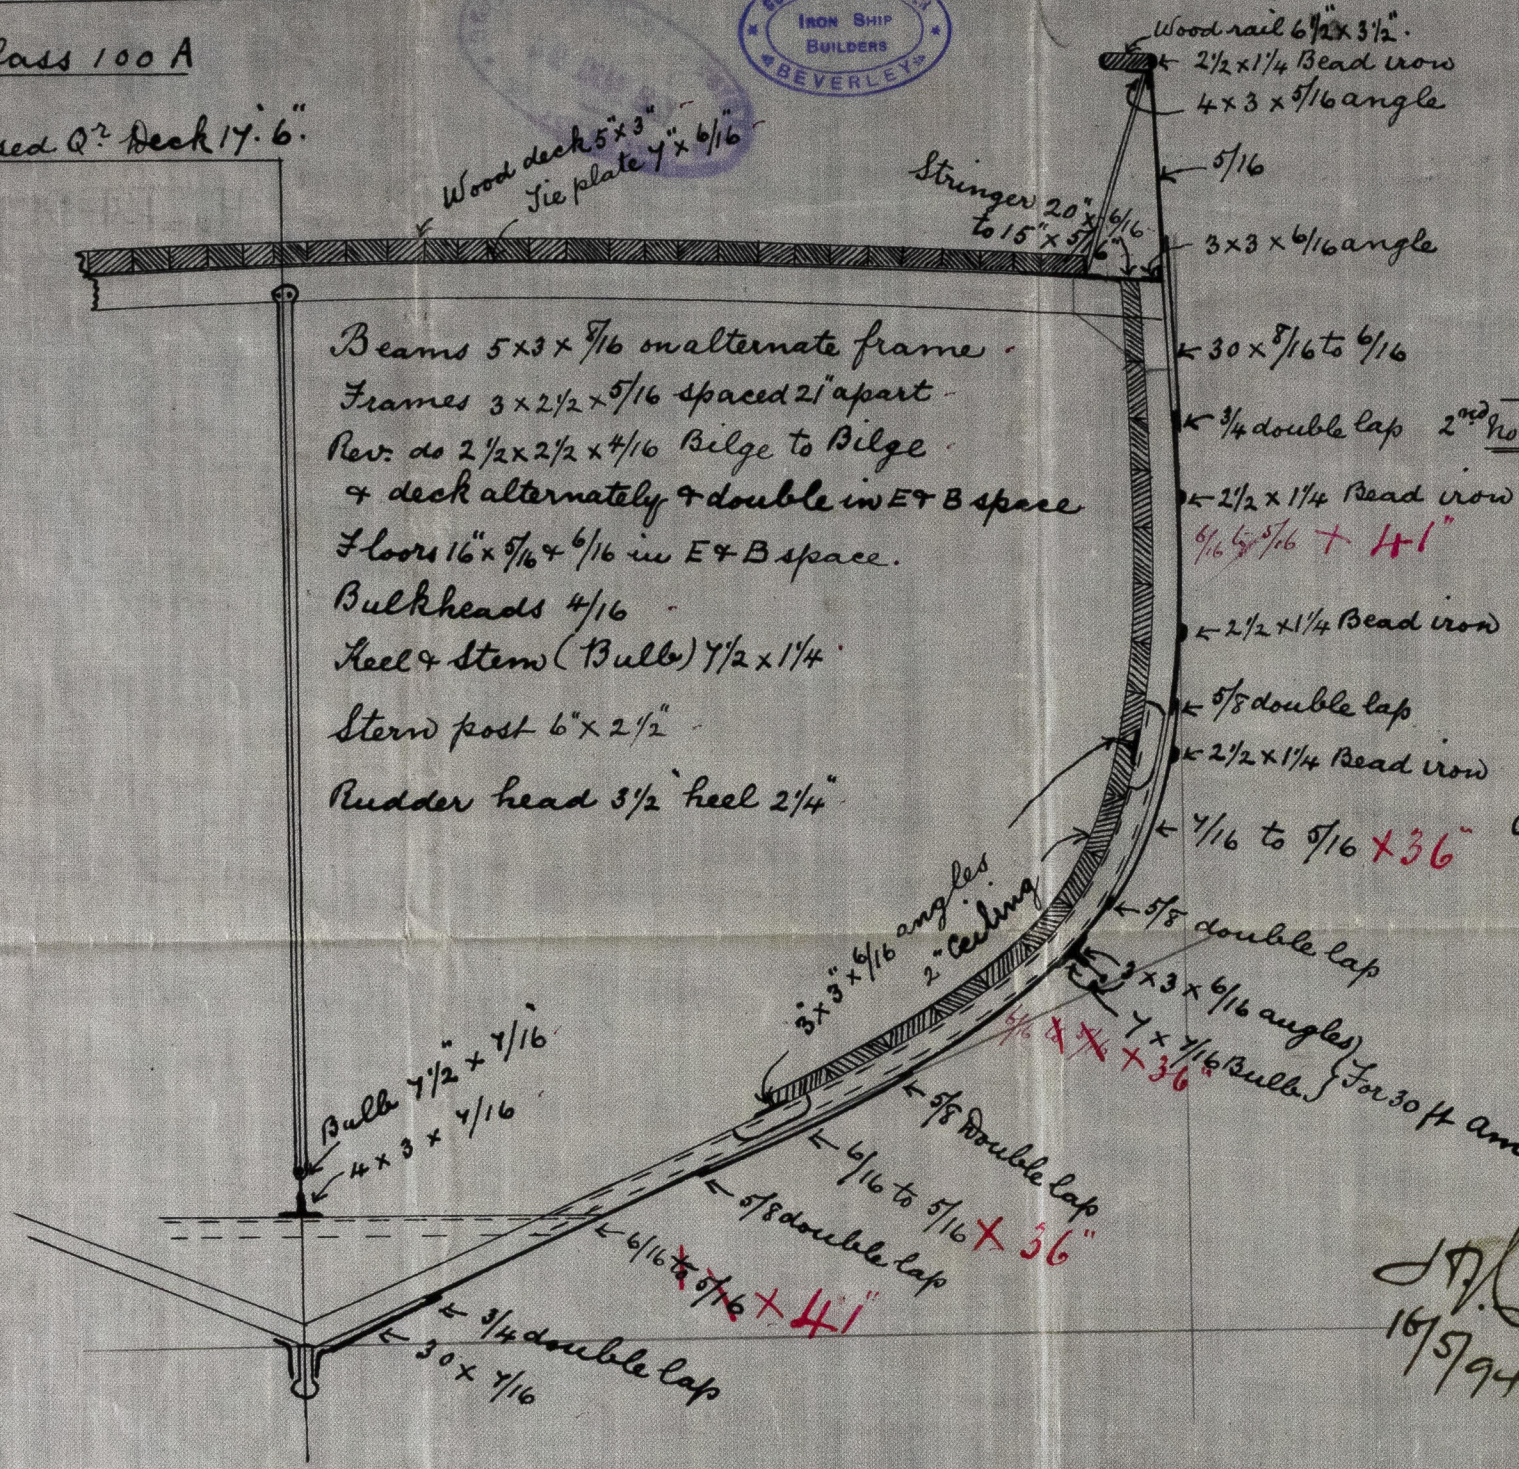

1/2 Girth	17.83
1/2 Breadth	10.20
Depth	12.33
1 st No.	40.36
	90.87
	28252
	32288
	363240
2 nd No.	3667.5132

$\frac{L}{D} = 7.3$
 $\frac{L}{B} = 4.4$

all shell butt straps to be 1/16" thicker than plates they connect.

Minimum depth 11' 10"

J.H.L.
16/5/94



Lloyd's Register
Foundation
HVL 409-0136


S/S Northbrook
Nav Report No: 9196



MIDSHIP SECTION

03'0" x 20'6" x 11'0" Hold

*Longitudinal section
1/2" dia. transverse
10' x 2 1/2"
1/2" dia. longitudinal
10' x 2 1/2"*

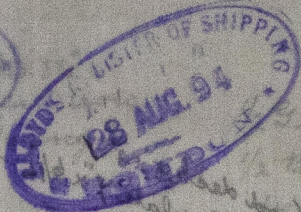

Class 100 A

HVL409-0136

*3 x 3 x 3/4 in. mild steel frame
3 x 3 x 3/4 in. spaced 21 apart
1/2" x 2 1/2" x 1/2" ridge to ridge
x back alternately 1/2" double in E & B
1/2" x 2 1/2" x 1/2" in E & B space
1/2" x 2 1/2" x 1/2" (1/2" x 1/2")

© 2019

Lloyd's Register
Foundation