

Hull Report No. 9209

N^o 390.

S. J. "Swift"

Midship Section

Scale $\frac{1}{2}" = 1 \text{ foot}$



Dimensions per rule 92'5 x 20'5 x 11'25

Class 100 A iron with steel shell

Half Breadth 10.25
 " Girth 18.45
 Depth 11.45

 40.45 = 1st no.
 92.5

 3469.3 = 2nd no.

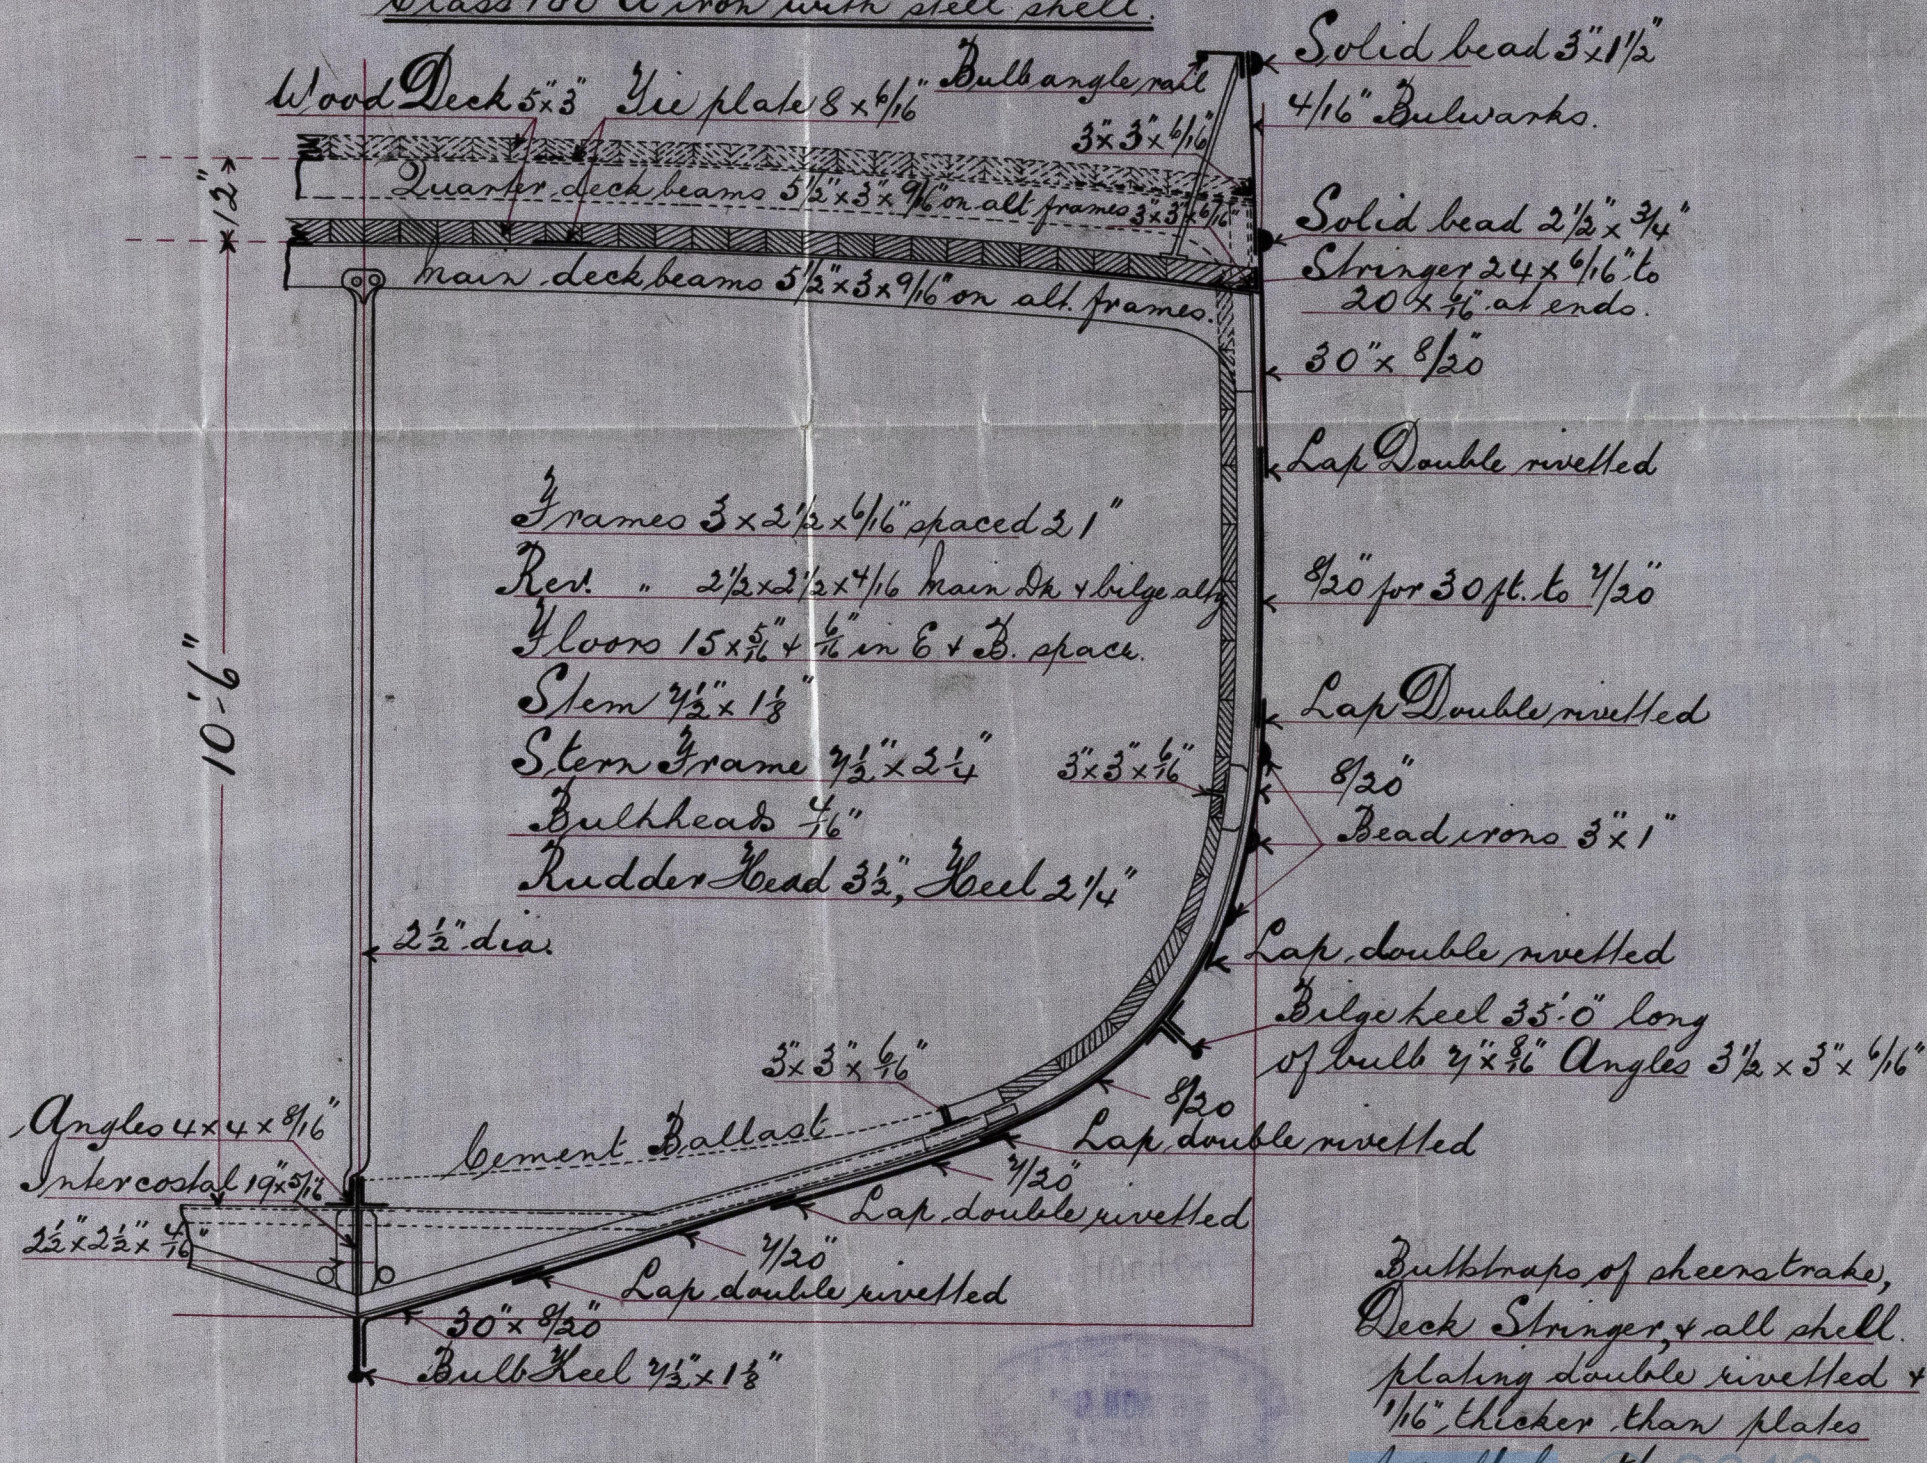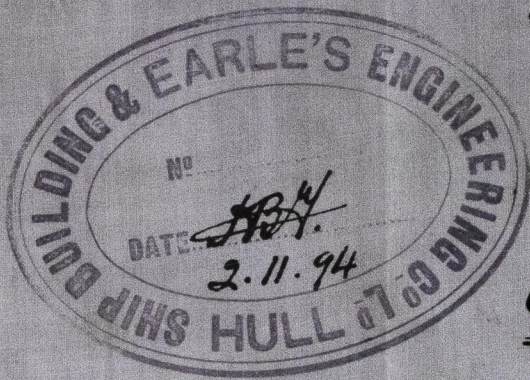

Bulkheads of sheers trake,
Deck Stringer, & all shell
plating double rivetted &
1/16" thicker than plates
for all length

s/s Swift


Hull Report No: 9209

Report No: 9209



HVL409-0201


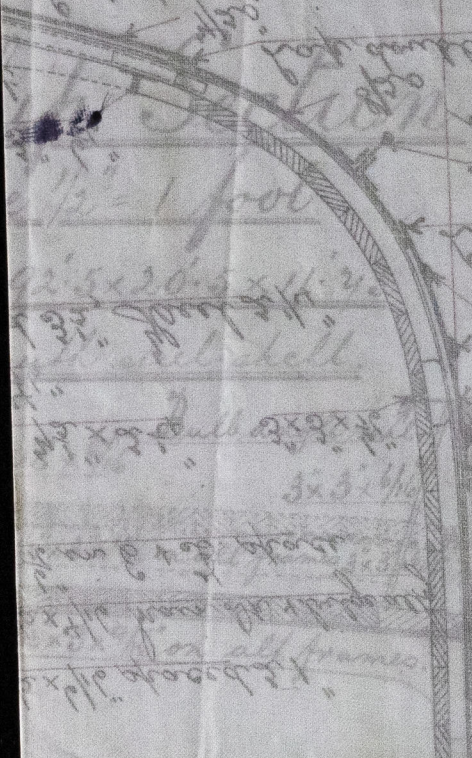




© 2019
Lloyd's Register
Foundation