

s/s Larne
Hull Report No: 9389

C. 6 & 60

2880a

Book 14, Page 39

s/s Larne"

No 4435—
Lloyds Test—
160 lbs
11/10/94 A.D.

see pitch screw stay
12 in number (about 15")


x 7163 shell	✓
8320 —	✓
8325 —	✓
7423 —	✓
x 7124 Box	✓
7164 —	✓
7778 —	✓
7158 7p	✓
7824 —	✓

HVL409-0312



© 2019

Lloyd's Register
Foundation

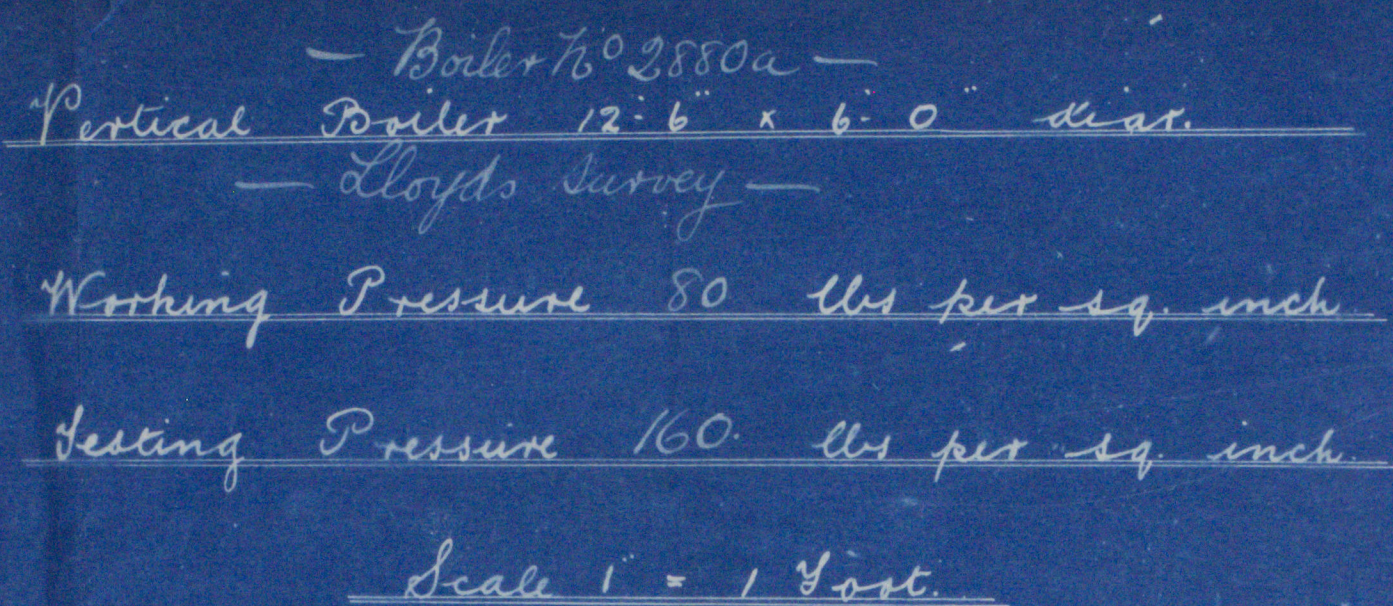

Long seams of shell double riveted $\frac{13}{16}$ " holes 3" pitch $\frac{1}{8}$ " cap $2\frac{1}{2}$ " diag.
Circum seams of shell single riveted $\frac{13}{16}$ " holes $1\frac{1}{16}$ " pitch $2\frac{1}{2}$ " cap.
Firebox seams single riveted 1" holes $2\frac{3}{16}$ " pitch 3" cap.