

*5/5 Jersey Hull Report No. 1*



Midship Section No 120

98' 0" x 20' 6" x 11' 0"

Length as per rule 96' 10 1/2"  
 Half m Breadth 10' 2 1/2"  
 Depth Keel to m D.B. 12' 4"

1/2 girth 14.91  
 1/2 breadth 10.20  
 Depth 12.33  
 1st h<sup>o</sup> 40.44  
 96.84  
 28 3 08  
 8 23 52  
 24 26 4  
 3 63 96  
 3914.4228-2 1/2

14.11.94 Class 100A

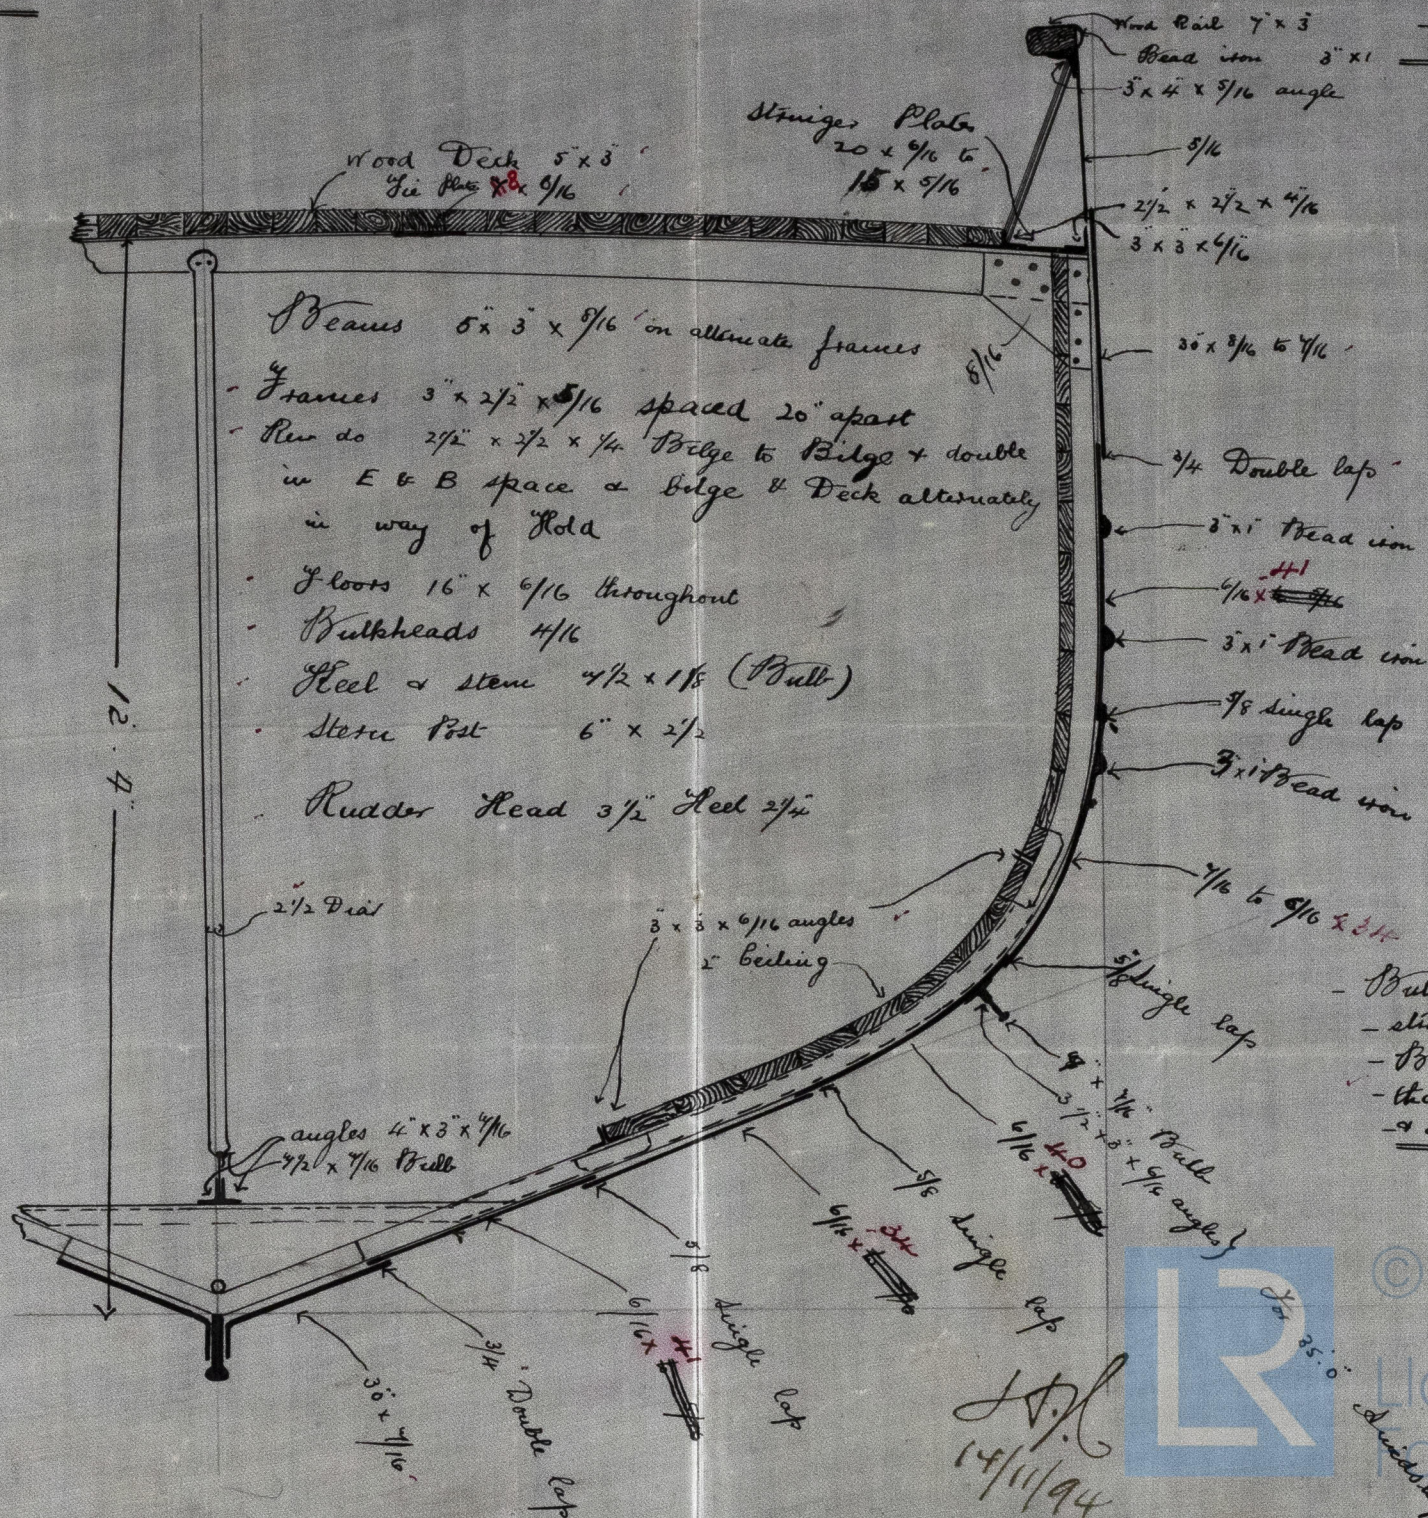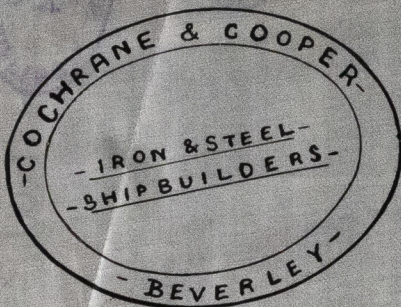

Moulded depth 11' 10"

- Butt straps of sheer strakes -  
 - stringer & one strake at -  
 - Bridge to be 1/16 thicker -  
 - than plates they connect -  
 - & all double riveted -

J.F.L.  
 14/11/94



Lloyd's Register  
 Foundation  
 HUL 410-0011



