

Lloyd's Register of British and Foreign Shipping.

s/s Monarchs(Report on Vessel No. *9577* Port *Hull*)*6/5/95*No. *2526*

SHIP FORGINGS OR CASTINGS.

I have to report that the undermentioned Iron ~~or Steel~~ Forgings ~~or Castings~~,
 manufactured by *Messrs Emmerson Walker & Thompson*
 of *Dunston* for the Vessel No. *122*, being built
 by *Messrs Cochran & Co* of *Hull*
 have been inspected by me as set forth below, and found to be, so far as can be seen,
sound

The words FORGINGS or CASTINGS, IRON or STEEL, should be struck out as may be required.

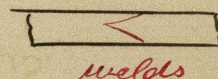
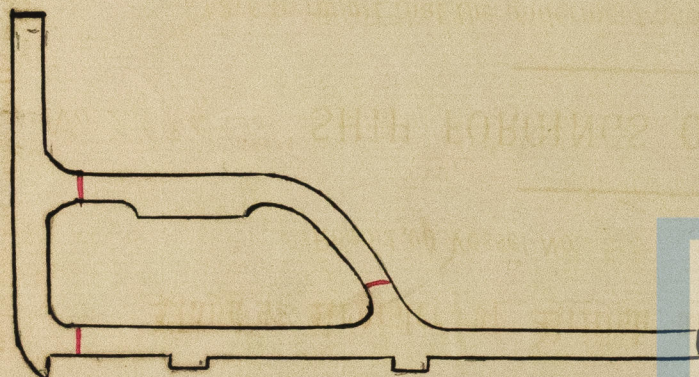
Mark on Forgings.

Lloyd's

No. *4222B**96*
John C Craig
Newcastle

	STERN FRAME.	RUDDER FRAME.	STEM.
Material* ...	<i>Scrap Iron</i>	<i>Scrap Iron</i>	/
How made ...	<i>Forged</i>	<i>Forged</i>	
Dimensions ...	<i>6 - 2 1/2</i>	<i>3 1/2 - 2 1/4</i>	
Progress on Inspection	<i>Finished</i>	<i>Forged & Smithed</i>	
Date when Inspected	<i>January 15/95</i>	<i>March 1-7-9-13/95</i>	

SKETCHES OF FRAMES SHOWING POSITION AND DESCRIPTION OF WELDS OF FORGINGS, OR PARTICULARS OF TESTS APPLIED TO CASTINGS.

*welds*

© 2019

Lloyd's Register
Foundation