

- MIDSHIP SECTION S T & N° 122 -

Cochran & Cooper Builders

- 93.0 x 20.6' x 11.0' Hold -


5/2 Monarch
Hull Report No:

- Length as p. rule 91.10 1/2 -
- 1/2 m. Breadth 10.2 1/2 -
- Depth keel to m.d.b. 12.4 -

Class 100A

Raised 2nd Deck 14.6

14.11.94

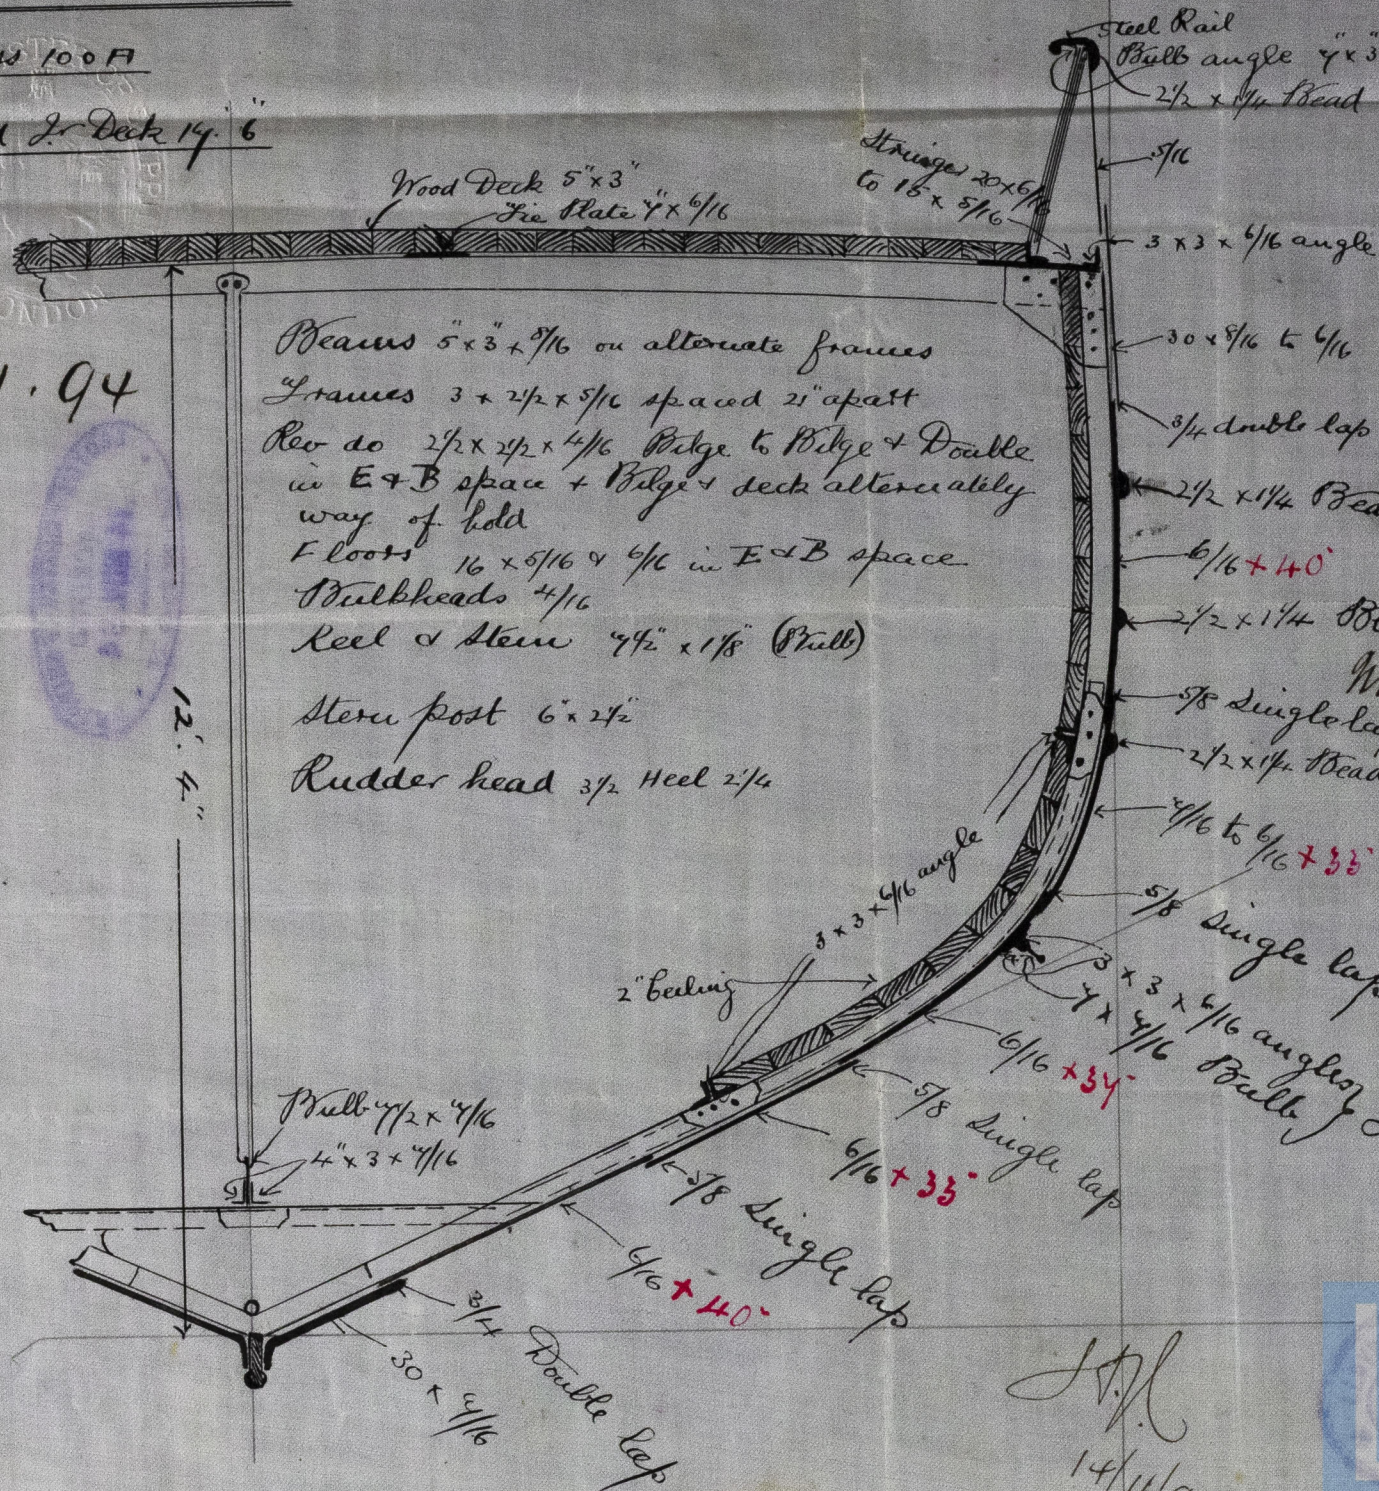

1/2 girth 14.83
1/2 Breadth 10.20

Depth 12.33

40.36

91.84

28252

32288

4036

36324

3404.84 32-2nd w.

Wouldn't depth 11.10


All shell straps to be 1/16" thicker than plates they connect

J.H.L.
14/11/94



Lloyd's Register
Foundation

HUL 410-0080

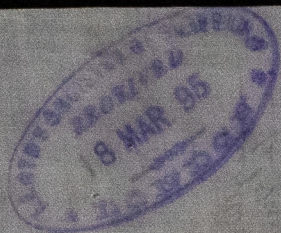

S/S Monarch
Hull Report No 9514



FILE 410-0080

Handwritten text, likely bleed-through from the reverse side of the page, appearing as mirrored cursive script.


Lloyd's Register
Foundation