



HVL 410-0307

8/5/62
Hull Report No. 9736

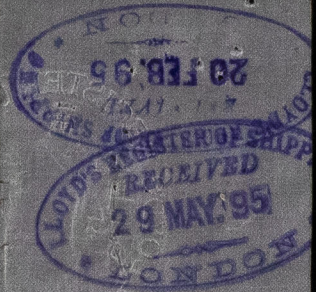

Scale 1/2 = one foot

HUL410-0307

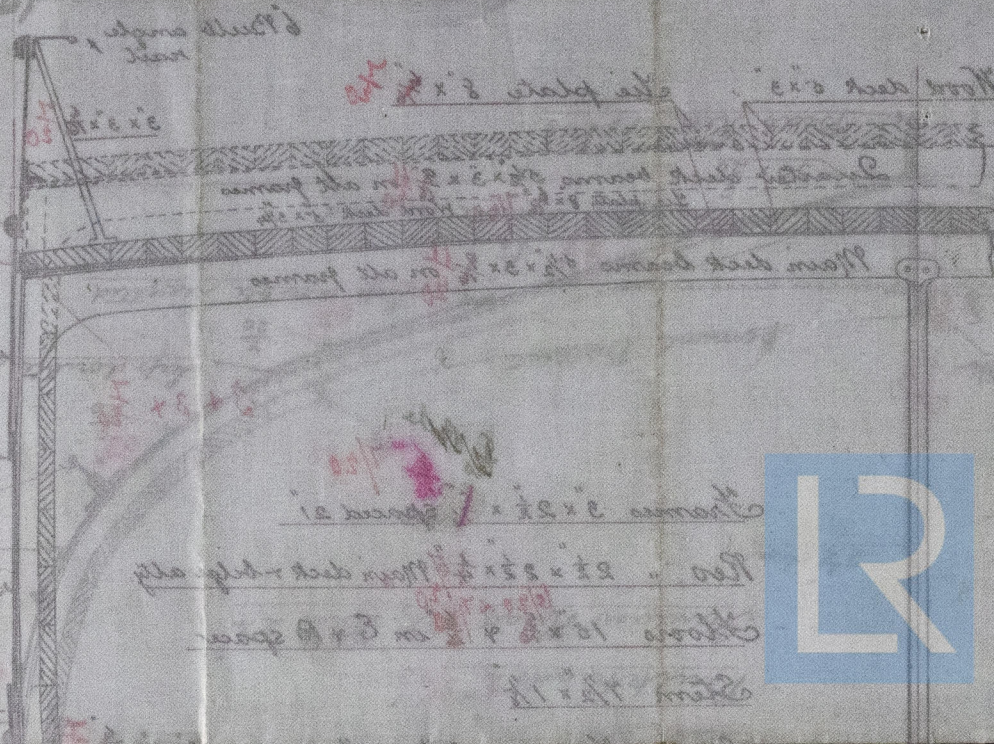

Lloyd's Register
Foundation