

4.6.95


*S/S Newfoundland*  
*Hull Report No.*  
 — MIDSHIP SECTION N° 134 —

— LENGTH AS PER RULE — 96.10 1/2 —  
 — HALF M BREADTH — 10.2 1/2 —  
 — DEPTH KEEL TO M.D.B. — 12.4 —

— 98.0 x 20.6 x 11.0 HOLD —  
 — SCALE 1/4" = 1 FOOT —

— CLASS 100A —

COCHRANE & COOPER  
 SHIPBUILDERS  
 BRYERLEY

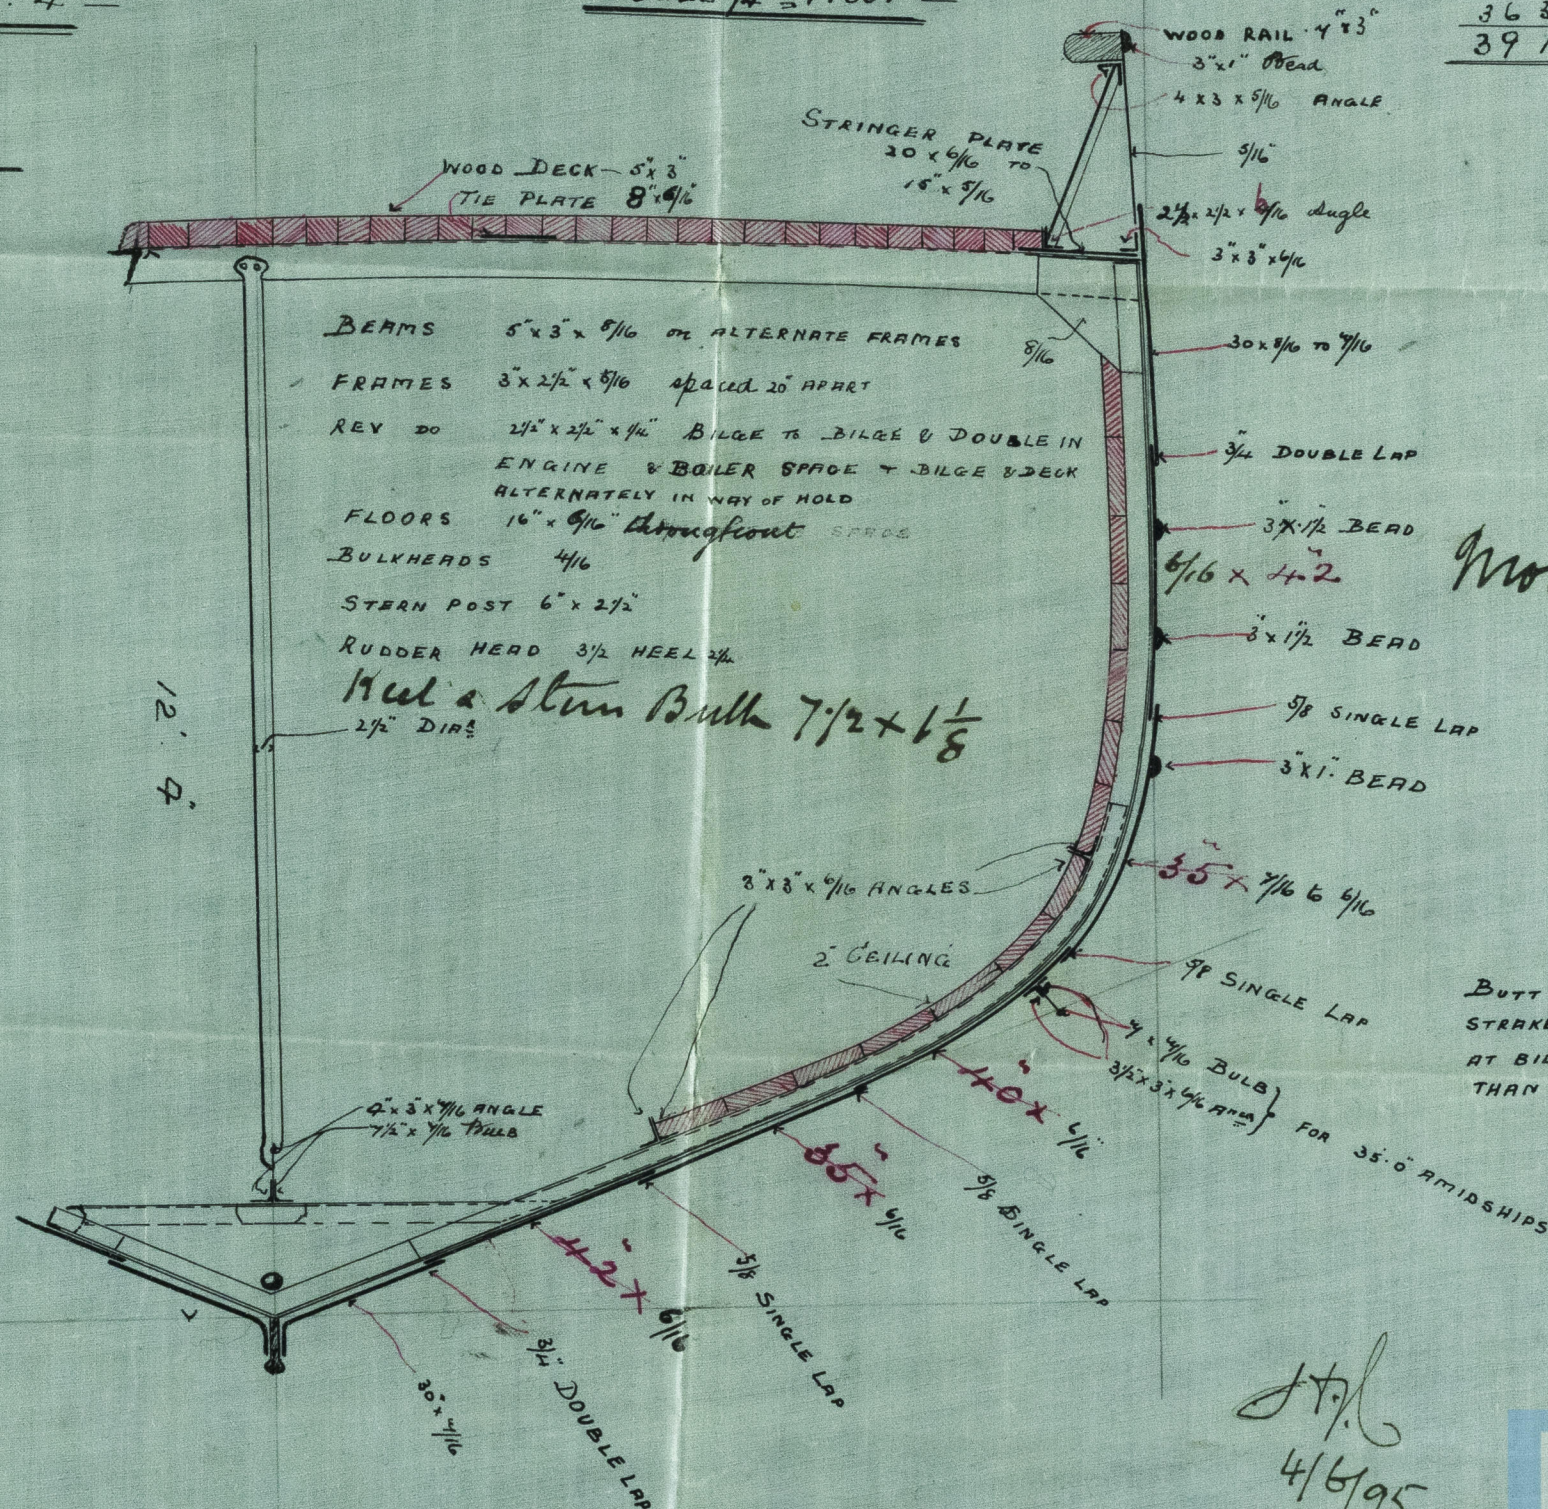

1/2 GIRTH 91  
 1/2 BREADTH 20  
 DEPTH 12.33  
 2nd 20.40 444

96.84

283.08

32352

24264

36396

3914.4228 2nd 20

7.8 D

4.7 D

*Moulded depth 11.10*

BUTT STRAPS OF SHEER  
 STRAKE STRINGER & STRAKE  
 AT BILGE TO BE 1/16 THICKER  
 THAN PLATES THEY CONNECT

*J.H.L.*  
 4/6/95





