

— COCHRANE & COOPER —

— Iron Shipbuilders —

— GROVEHILL SHIPYARD —

— BEVERLEY —

— S.S. N° 134 —

— PLAN SHEWING ARRANGEMENT —

— OF BALLAST TANKS ETC —

— SCALE $\frac{1}{4}$ - 1 FT —


*1/2 after foundling
Hull Report No*

— DIMENSIONS —

— LENGTH BP 98' 0" —

— BREADTH EX 20' 6" —

— DEPTH OF HOLD 11' 0" —

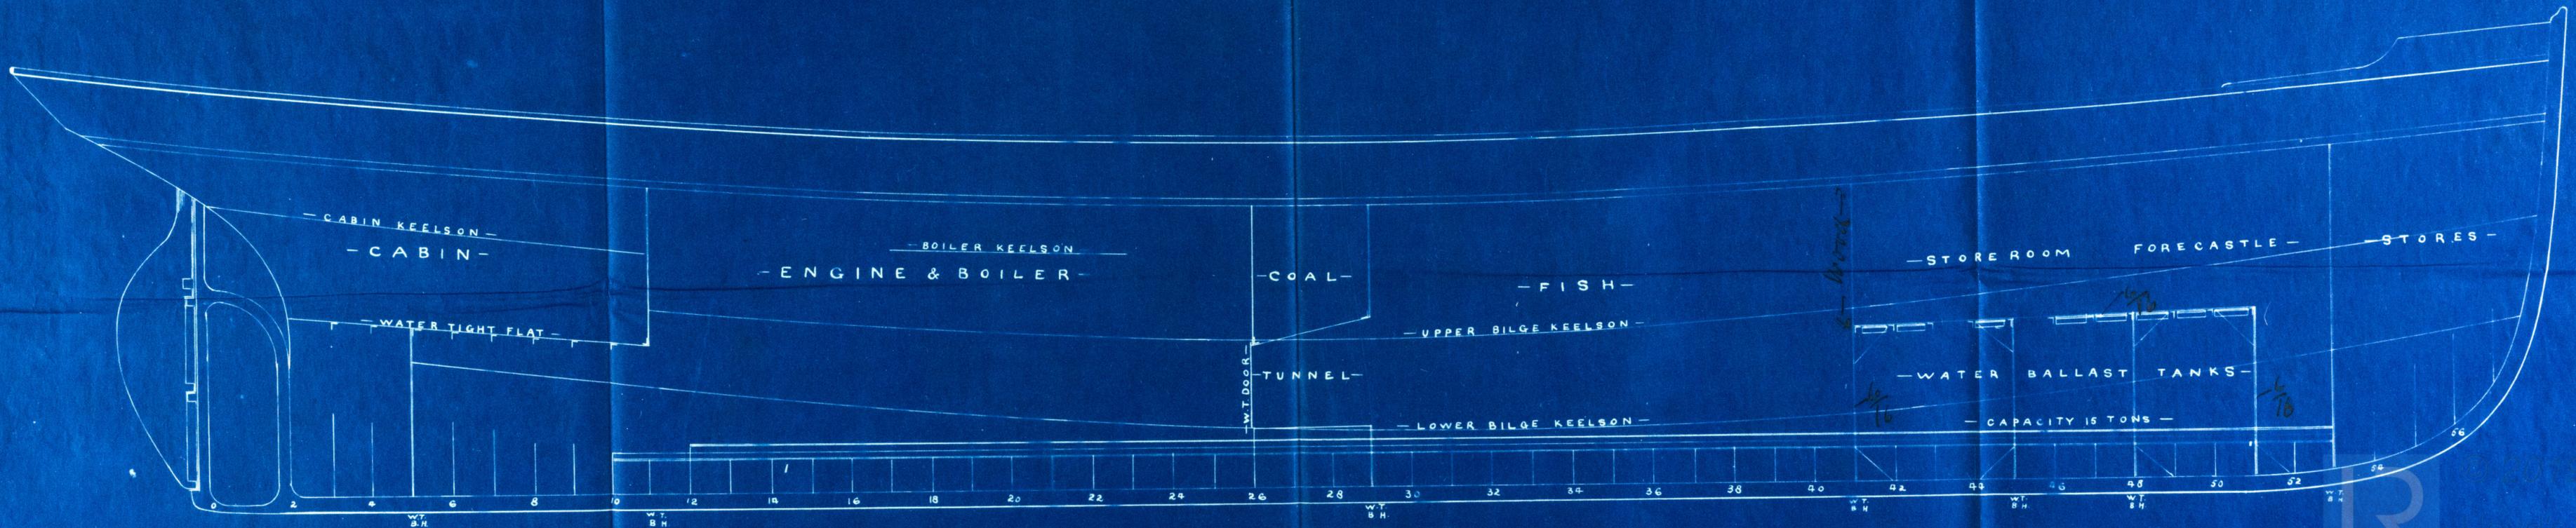

R
Lloyds Reg
Hull No 078

s/ Newfoundland
Hull Report No. 9948

HULL 11-0078



© 2019

Lloyd's Register
Foundation