

— LENGTH AS PER RULE — — — 91. 10 1/2 —
— 1/2 IN BREADTH — — — 10. 2 1/2 —
— DEPTH K. TO. M. D. B — — — 12. 4 —

— GLASS 100 A —

RAISED 2. DECK 17.6'

- Cockrane & Cooper -
- Smithers -
- Beversley -

S/S Undaunted
Hall Report to
MIDSHIP SECTION

STEAM TRAWLER

N. 129


93:0 r 20:6, 11:0 Hld

$\frac{1}{2}$ Girl 14.83
 10.20
 12.33
 1st 2nd 40 36
 91.87
 28252
 32288
 4036
 36324
 3707.8732

Woulded depth 11 " 10

All shell straps
to be $\frac{1}{16}$ " thicker
than plates they
connect
All butts double rivetted

Scale $\frac{1}{2}$ " - 1 foot

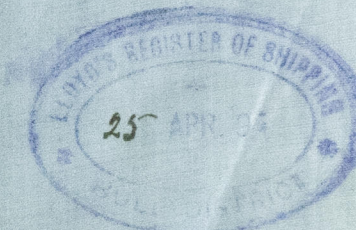

© 2019
Lloyd's Register
Foundation
HUL 411-0123

HVL 411-0123

ENCLOSURE









© 2019

Lloyd's Register
Foundation