

The words FORGINGS or CASTINGS, IRON or STEEL, should be struck out as may be required.

Lloyd's Register of British and Foreign Shipping.

S/S Newfoundland
(Report on Vessel No. 9945 Port Hull 9/8/95)

No. 2676 SHIP FORGINGS OR CASTINGS.

I have to report that the undermentioned Iron or ~~Steel~~ Forgings or ~~Castings~~,
manufactured by Messrs Emmerson Walker & Thompson
of Dunston for the Vessel No. 134, being built
by Messrs Cochran Cooper & Co of Hull
have been inspected by me as set forth below, and found to be, so far as can be seen,
Sound


Mark on Forgings.

Lloyd's
No. 45615
96

John C Craig
Newcastle
6.8.95

	STERN FRAME.	RUDDER FRAME.	STEM.
Material* ...	<u>Scrap Iron</u>	<u>Scrap Iron</u>	/
How made ...	<u>Forged</u>	<u>Forged</u>	
Dimensions ...	<u>6 - 2 1/2</u>	<u>3 1/2 - 2 1/4</u>	
Progress on Inspection	<u>Finished</u>	<u>Finished</u>	
Date when Inspected	<u>May 31/95</u>	<u>July 26/95</u>	

SKETCHES OF FRAMES SHOWING POSITION AND DESCRIPTION OF WELDS OF FORGINGS, OR PARTICULARS OF TESTS APPLIED TO CASTINGS.

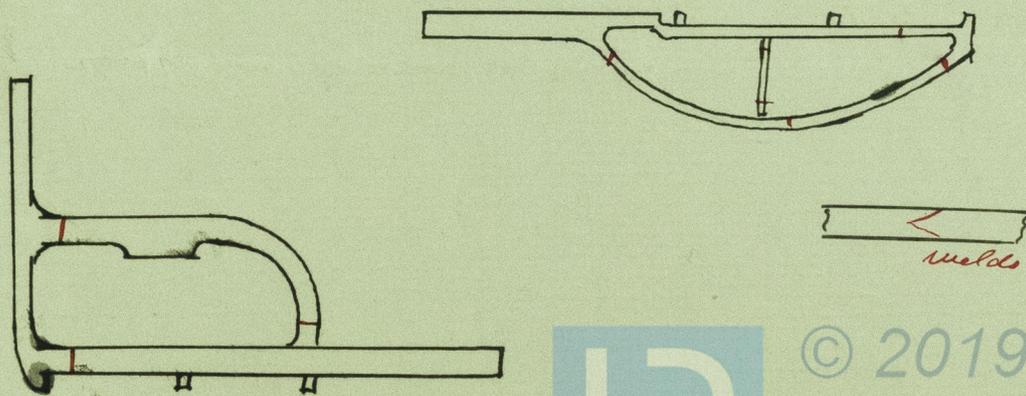

© 2019

Lloyd's Register
Foundation