


A circular blue ink stamp. The outer ring contains the text 'EARLE'S ENGINEERING' at the top and 'SHIP HULL BUILDING' at the bottom. In the center, there is a date stamp 'FEB 15 1908' and some faint, illegible handwritten text above it.

Scale  $\frac{1}{2}'' = \text{one foot.}$

Half Breadth	10.25
" Girth	18.75
" Depth	11.75

$$\begin{array}{r} \sqrt{40.75 = 1^{st} \text{ no.}} \\ 92.5 \\ \hline 3769.3 = 2^{nd} \text{ no.} \end{array}$$

4-5  
8-0

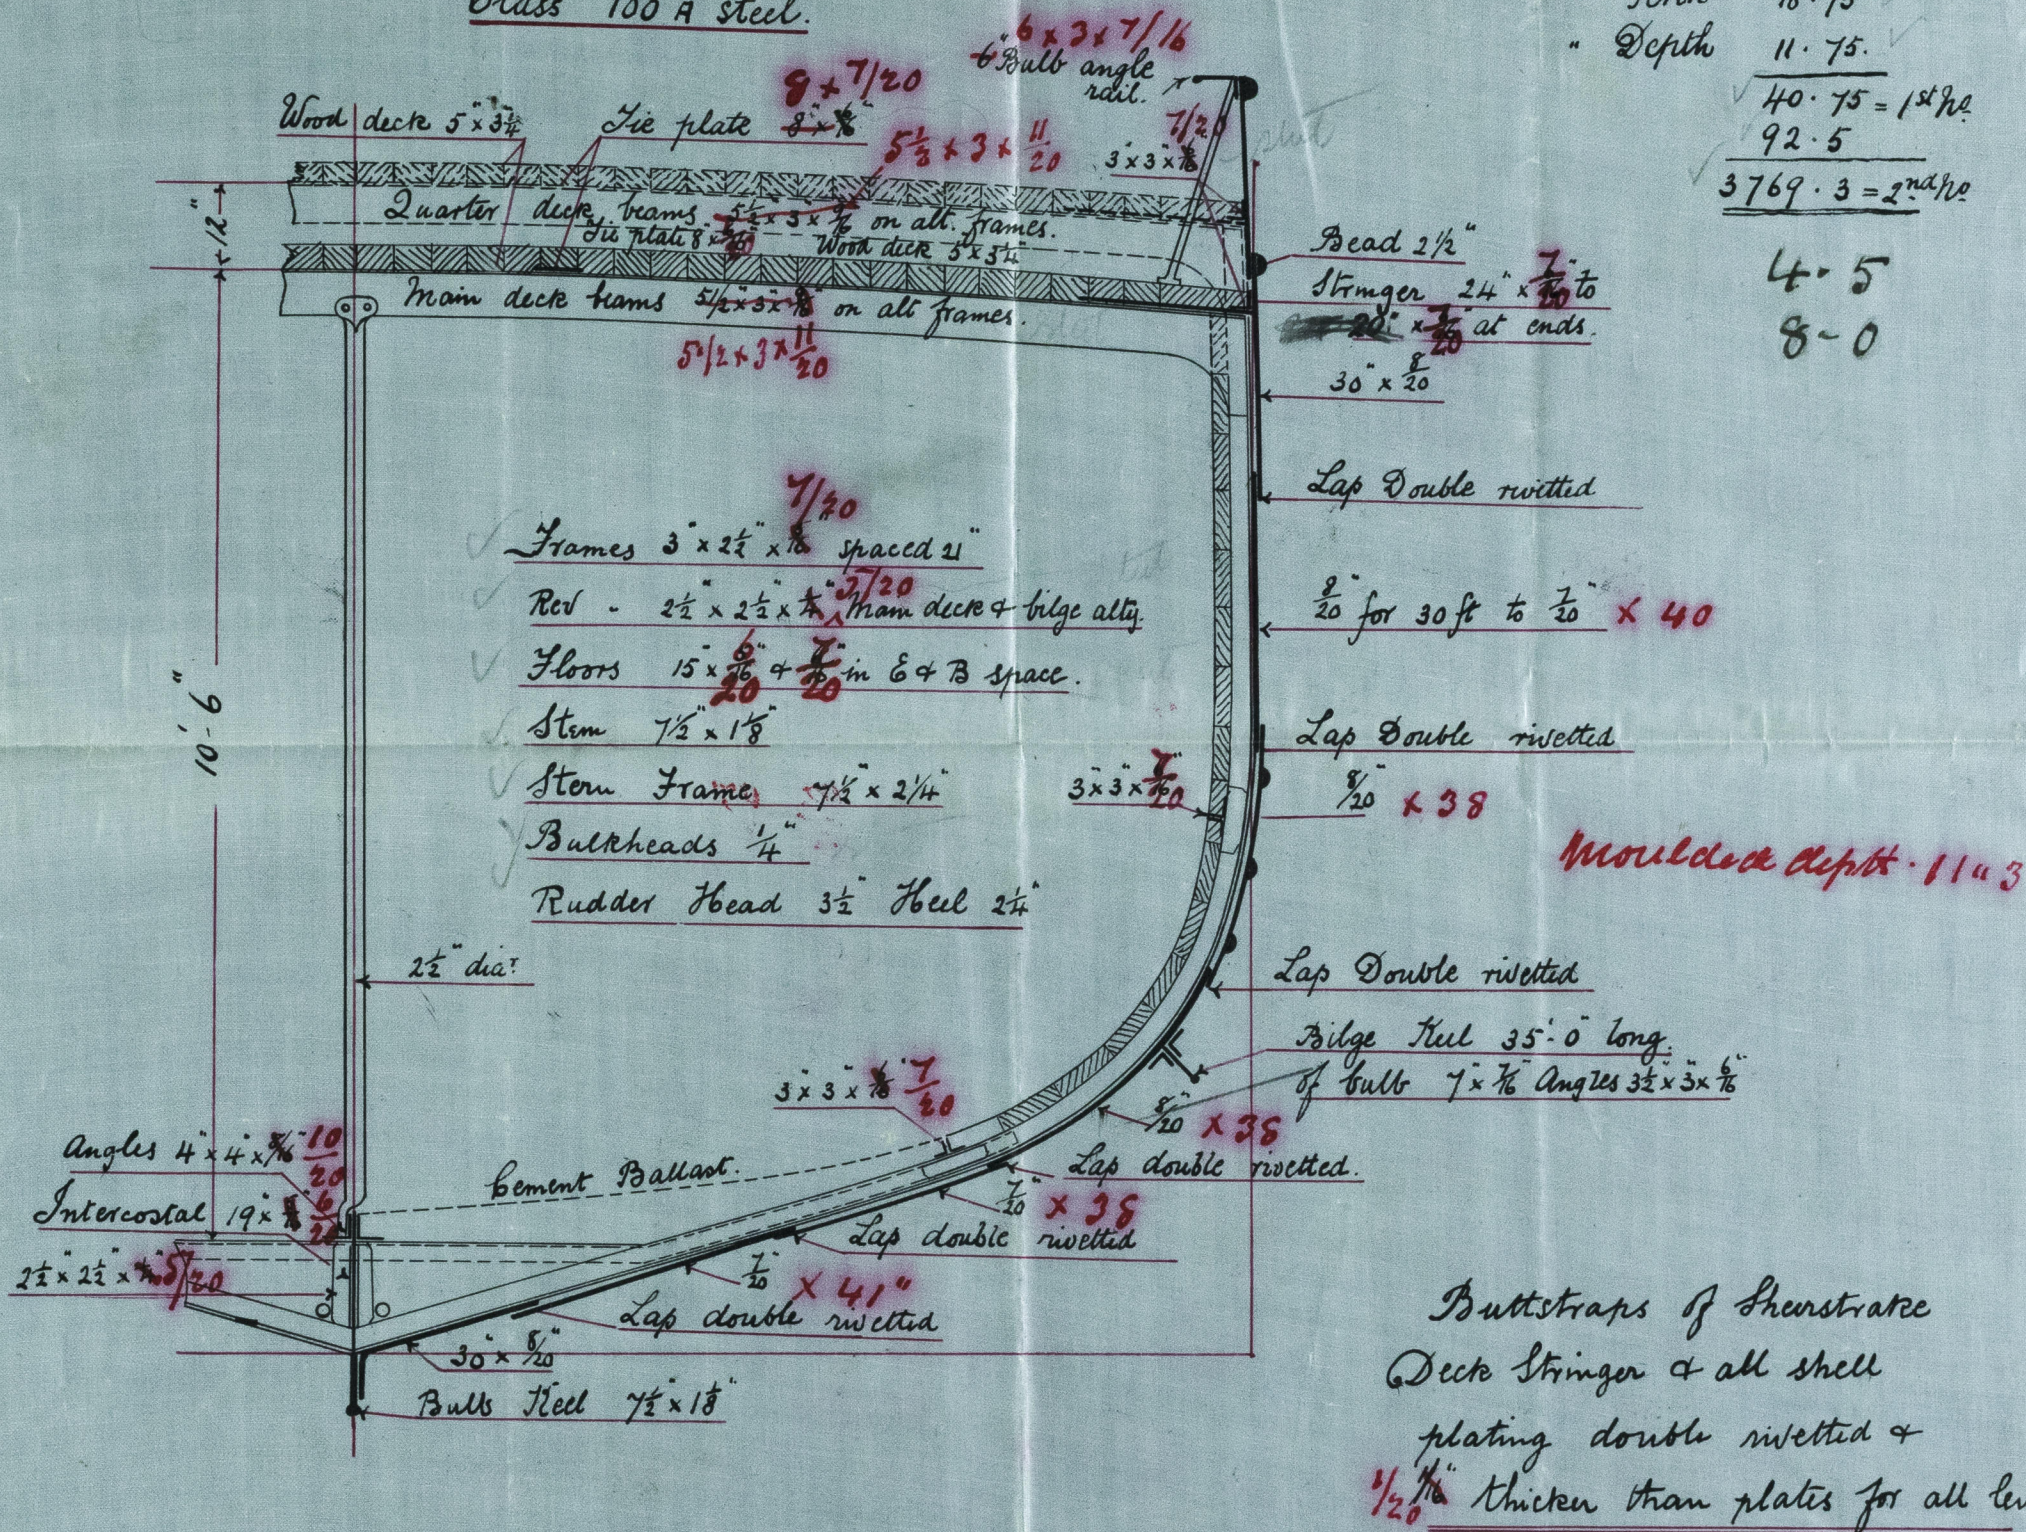

Both this ship's chub is a repeat of Nov 97. & ship's.



RECEIVED  
2 OCT 1995  
LONDON







Class 100 A steel.

7-2  
0-0

*[Faint handwritten notes at the bottom of the page, possibly bleed-through from the reverse side.]*

$\frac{1}{2} \times \frac{1}{2}$

© 20

Lloyd Found