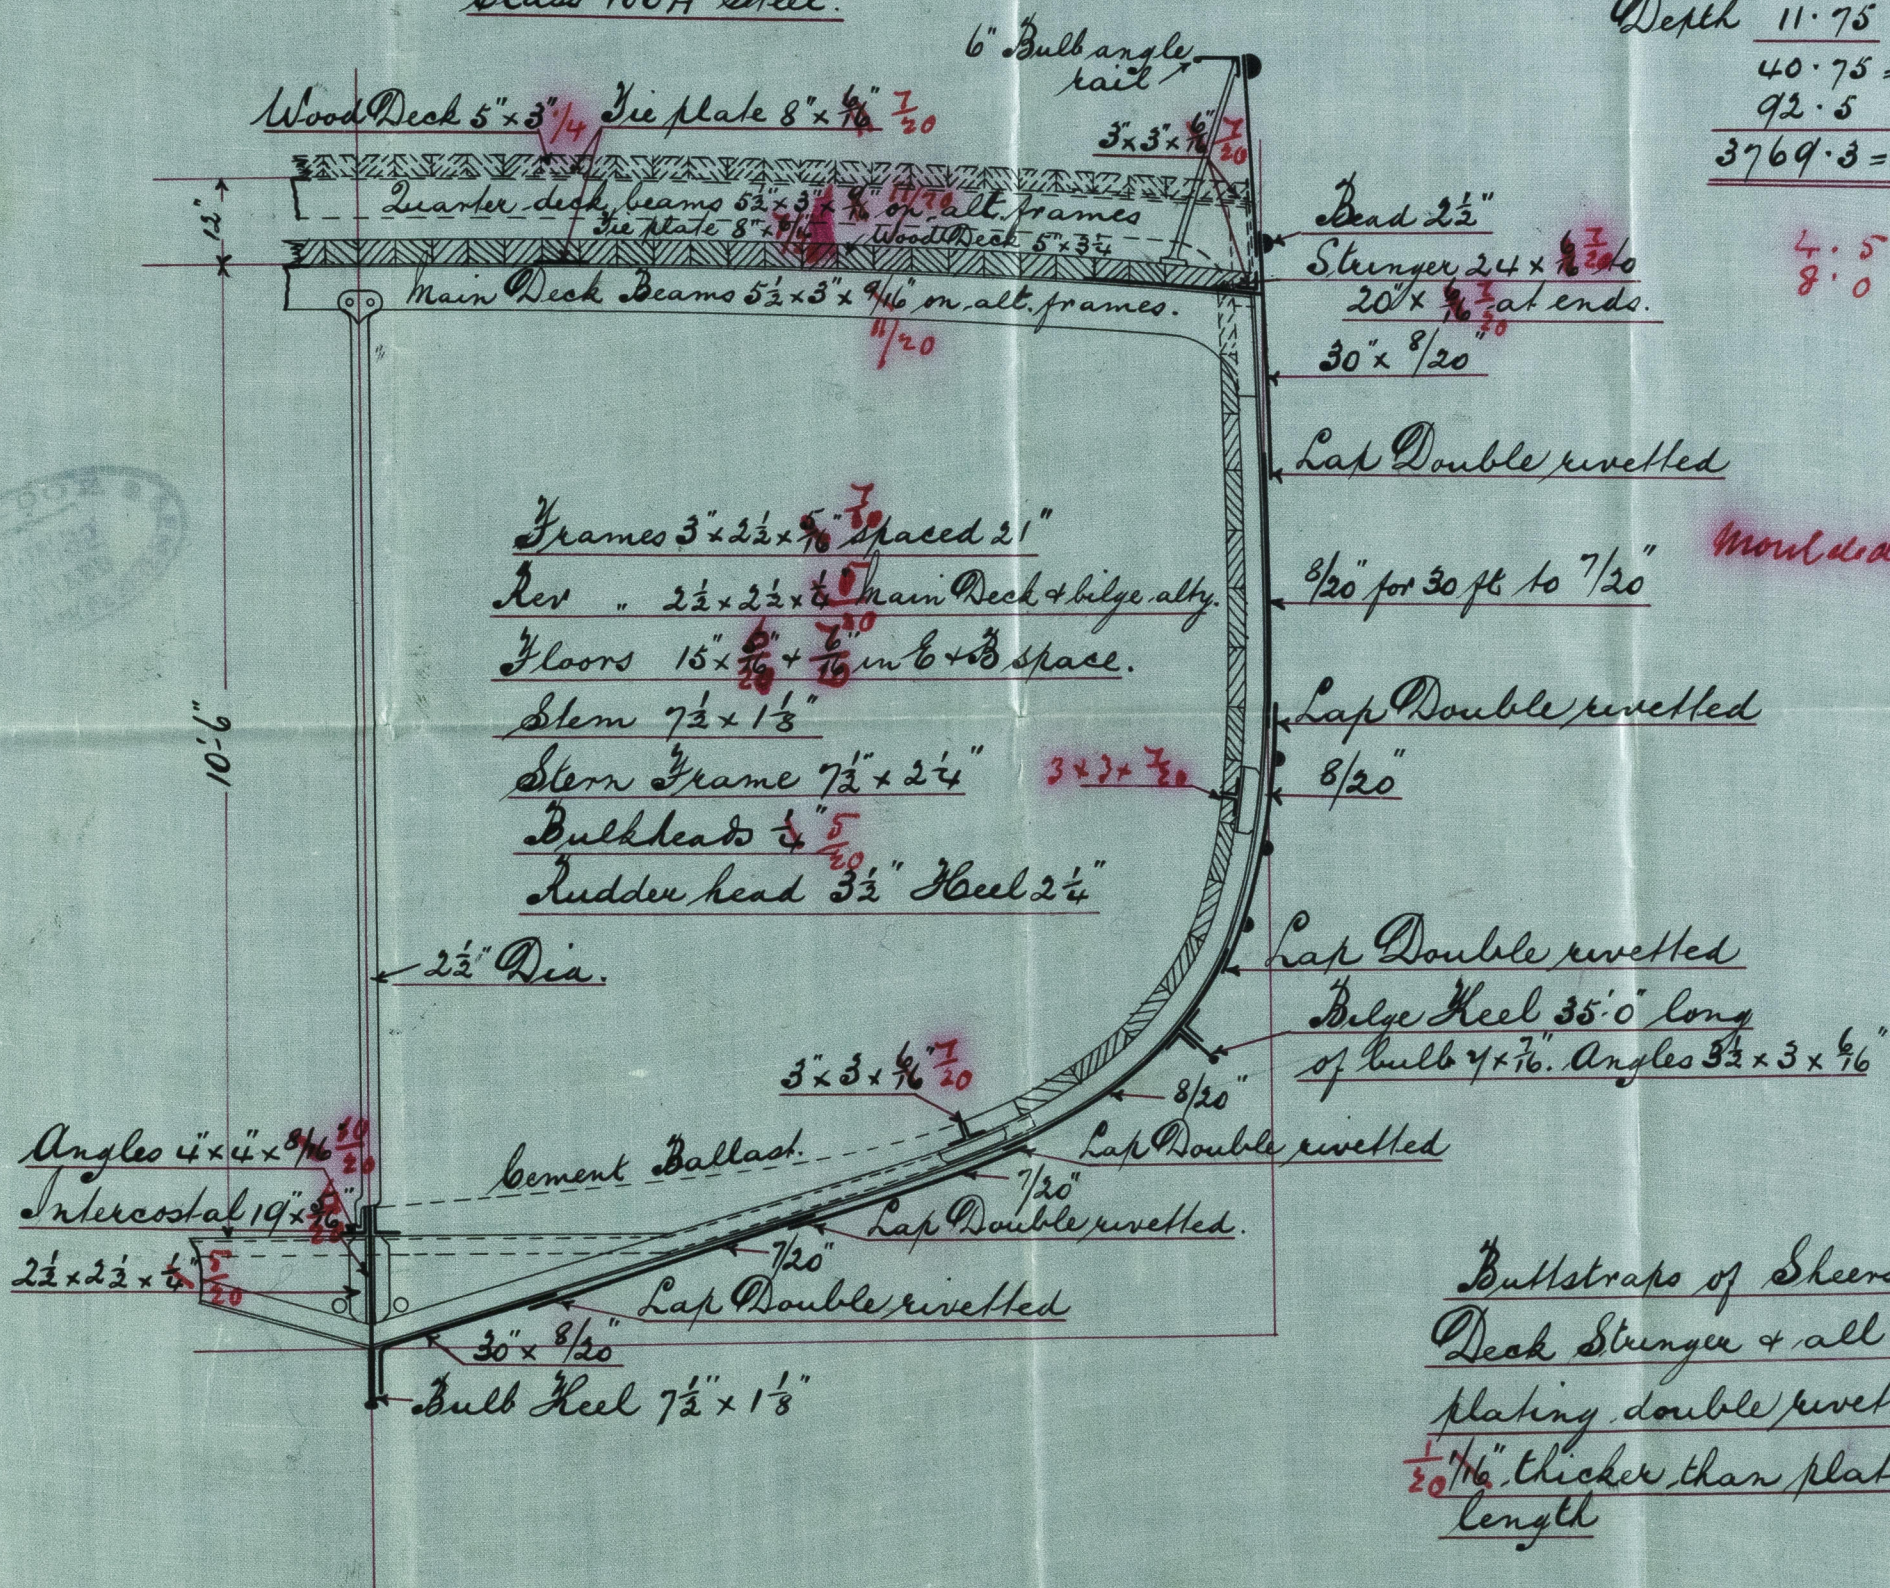


10097

Scale $\frac{1}{2}$ " = one foot


Half Breadth 10.25
" Girth 18.75
Depth 11.75

92.5

$$3769 \cdot 3 = 2^{\text{nd}} \text{ no.}$$


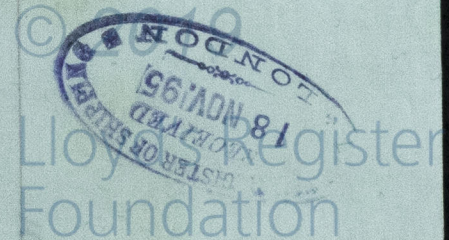
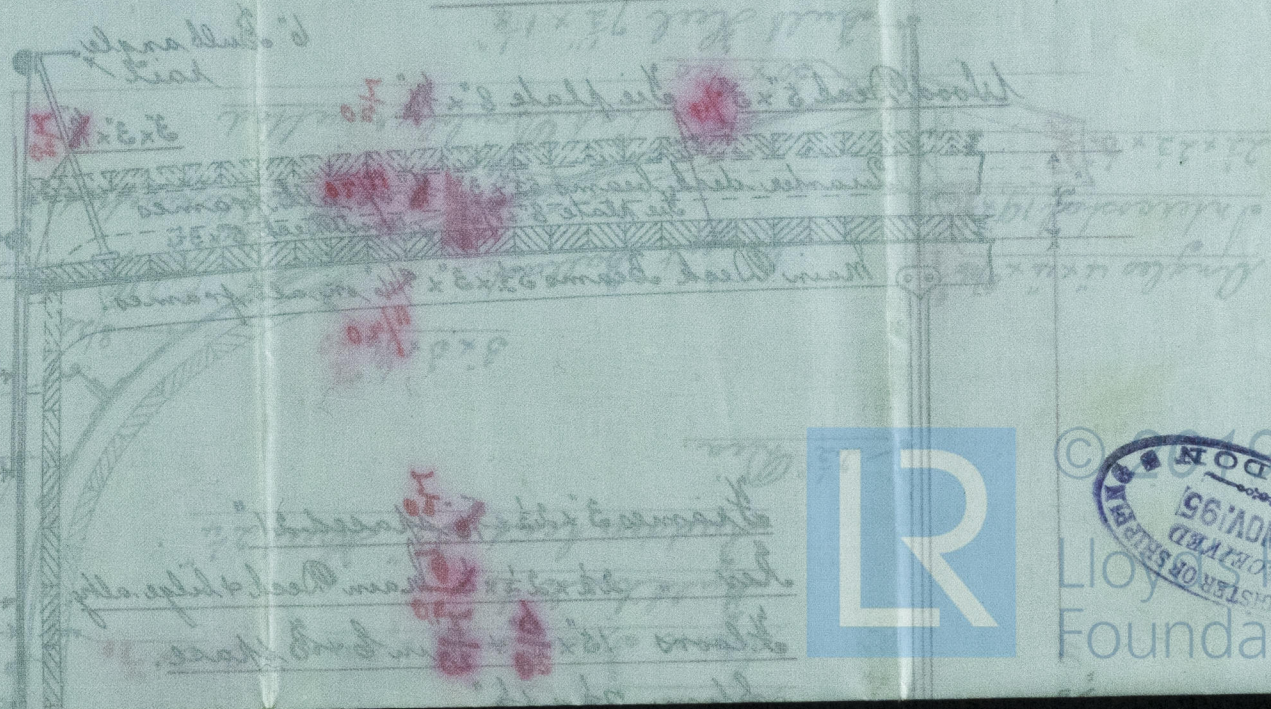
Bullstraps of Sheerstrake
Deck Stringer & all shell
plating double rivetted &
 $\frac{1}{2}$ to $\frac{3}{4}$ " thicker than plates for all
length

s/s *Nomadic*
Hull Report No: 10097

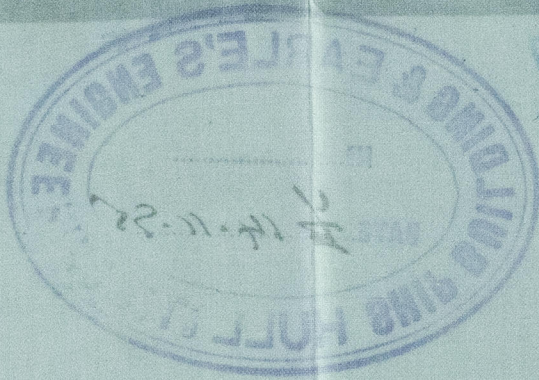

Midship Section
Scale 1/2" = one foot

Dimensions per rule 23: 26' 0" x 11' 7 1/2"
Class 100A steel
Hull steel 7 1/2" x 1 1/2"



Lloyds Register
Foundation