

9.9.95

— DIMENSIONS —
 LENGTH AS PER RULE — 106.9
 HALF MAIN BREADTH — 10.5½
 DEPTH KEEL TO M.D.B. — 12.6

*s/s Admiral
 Hull Report*

— MIDSHIP SECTION. S. S. N° 143 —

— 108.0' x 21.0' x 11.6' HOLD —

— WELL BOAT —

— RAISED QUARTER DECK —


— FORECASTLE DECK —

— CLASS-100A —

— COCHRANE & COOPER —

— SHIPBUILDERS —

— BEVERLEY —

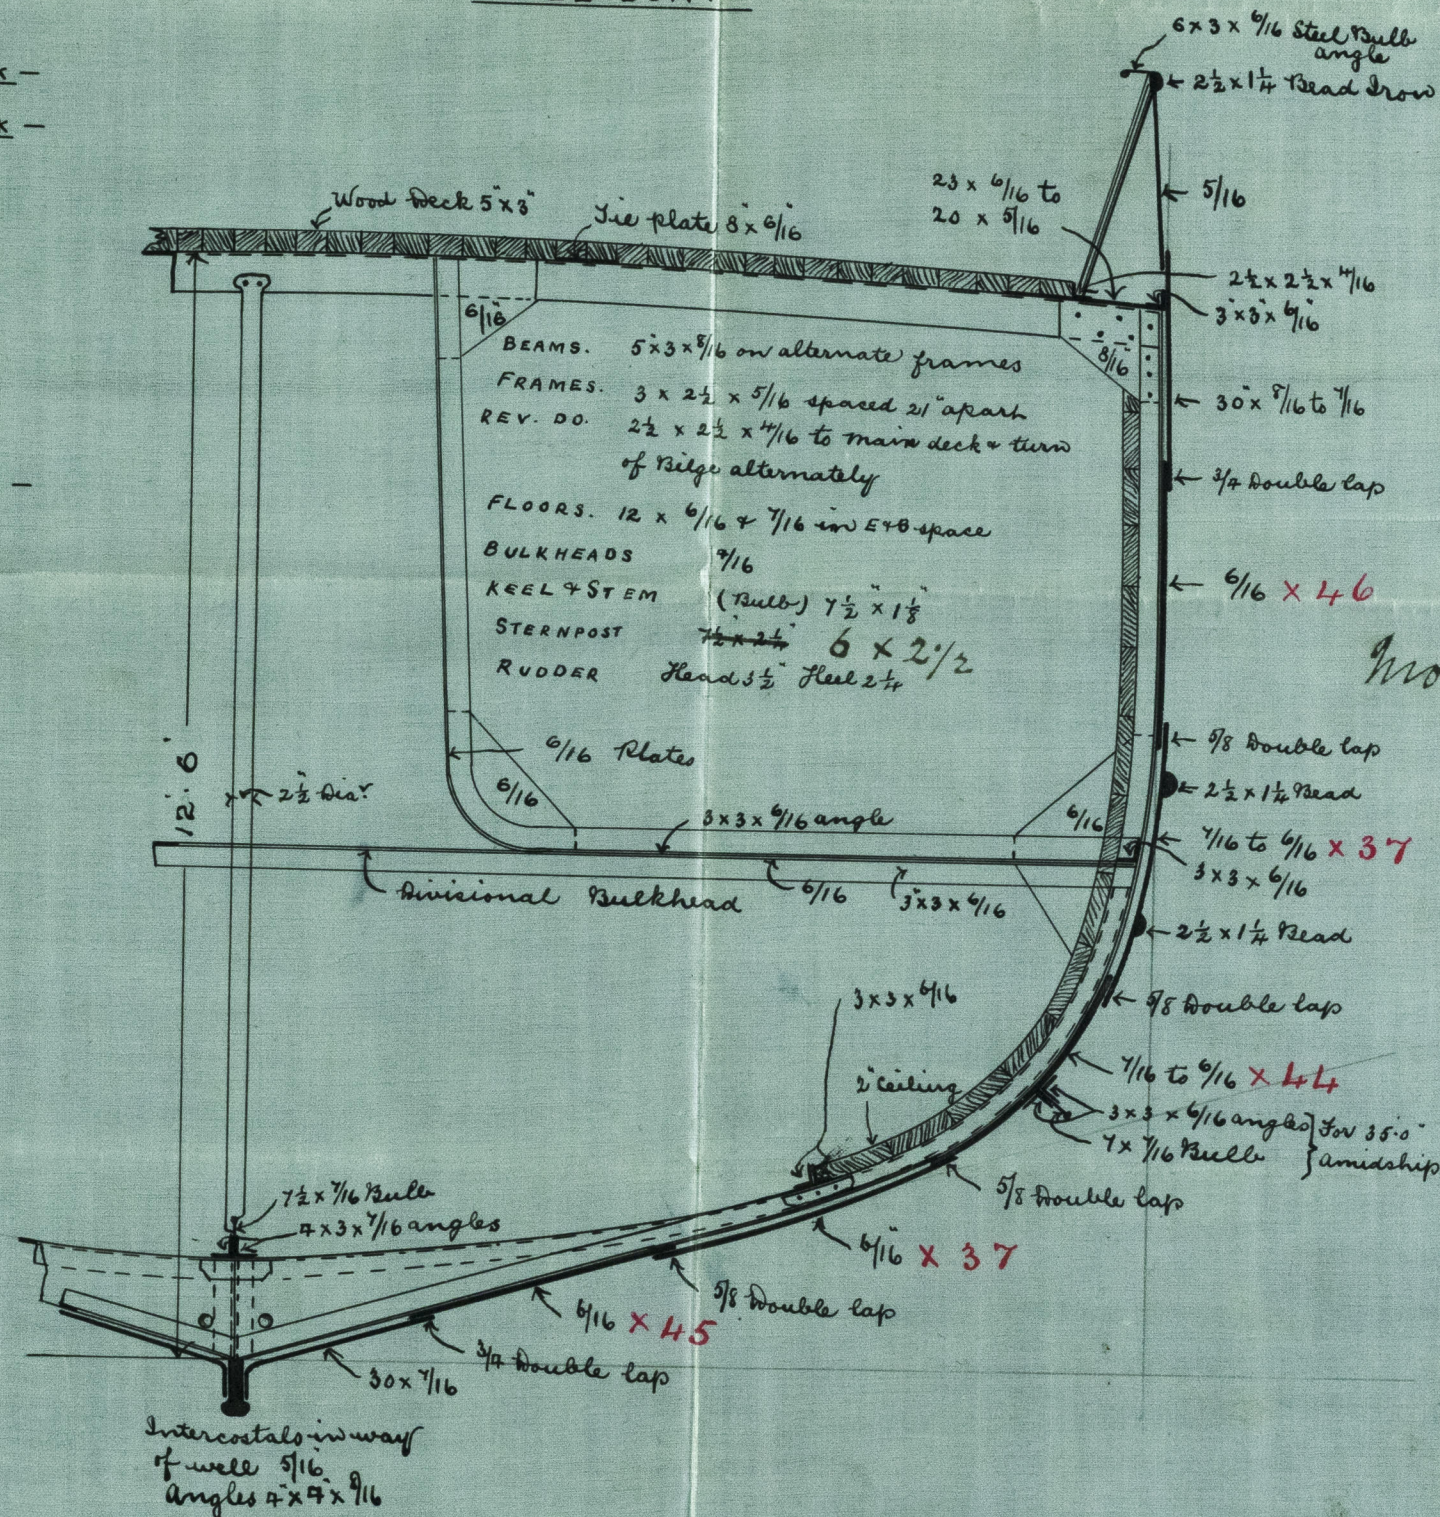


½ Girth 18.75
 ½ Breadth 10.46
 Depth 12.5
 41.71 1st no
 106.75
 20855
 29194
 25026
 41710
 4452.5425 2nd no

Moulded depth 12"0

*All butt straps to
 thicker than plates
 they connect & all
 double rivetted*

9.9.95

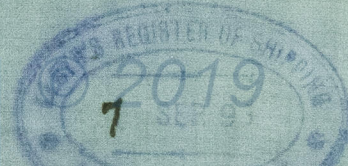

Lloyd's Register
 Foundation

HUL611-0427

LOYD'S REGISTER OF SHIPPLERS
RECEIVED
8 FEB. 1896
LONDON











© 2019

Lloyd's Register
Foundation