

TUES. JUN 16 1896

Received at Hull Office, 18/12/1895

Lloyd's Register of British and Foreign Shipping.

5/5 Admirals
(Report on Vessel No. 10250 Port Hull)

18/12/95


No. 2864 SHIP FORGINGS OR CASTINGS.

I have to report that the undermentioned Iron ~~or Steel~~ Forgings ~~or Castings~~,
manufactured by Messrs Emerson Walker & Thompson
of Dunston for the Vessel No. 143, being built
by Messrs Cochran Cooper & Co of Hull
have been inspected by me as set forth below, and found to be, so far as can be seen,
Sound

The words FORGINGS or CASTINGS, IRON or STEEL, should be struck out as may be required.

Mark on Forgings.


Lloyd's
No. 49325
JB

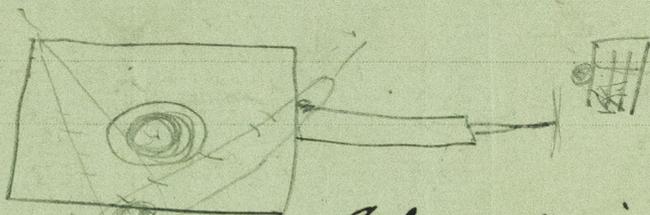

John C Craig
Newcastle
17. 12. 95

	STERN FRAME.	RUDDER FRAME.	STEM.
Material*	<u>Scrap Iron</u>	<u>Scrap Iron</u>	/
How made	<u>Forged</u>	<u>Forged</u>	
Dimensions	<u>6 - 2 1/2</u>	<u>3 1/2 - 2 1/4</u>	
Progress on Inspection	<u>Finished</u>	<u>Forged & Smithed</u>	
Date when Inspected	<u>October 10/95</u>	<u>November 16-25</u> <u>December 4/95</u>	

SKETCHES OF FRAMES SHOWING POSITION AND DESCRIPTION OF WELDS OF FORGINGS, OR PARTICULARS OF TESTS APPLIED TO CASTINGS.

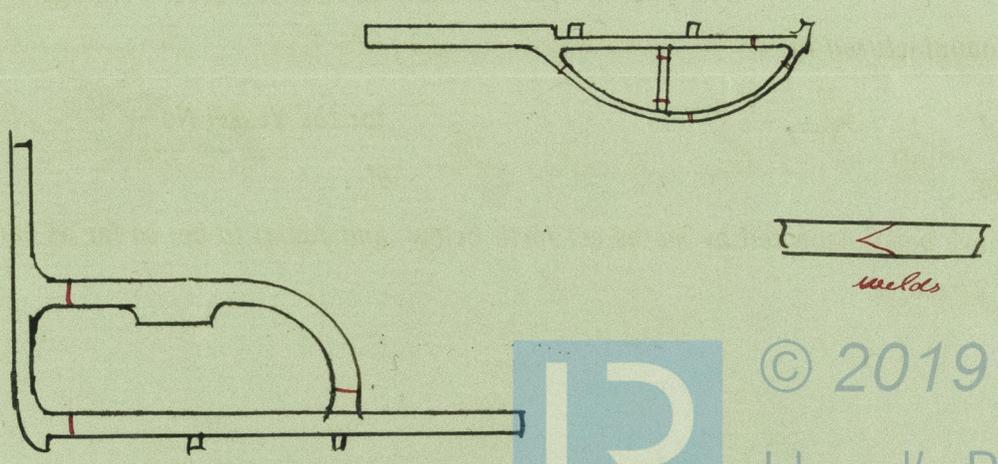

© 2019

Lloyd's Register
Foundation

* If of Iron, state whether scrap or puddled Iron.