

6.

Received at *Hull* Office, *29/6/1896*

Lloyd's Register of British and Foreign Shipping.

3/s Monarch
(Report on Vessel No. *10603* Port *Hull*)

No. *3177* SHIP FORGINGS OR CASTINGS.


I have to report that the undermentioned Iron or Steel Forgings or Castings, manufactured by *Messrs Emmerson Walker & Thompson* of *Dunston* for the Vessel No. *167*, being built by *Messrs Cook Weldon & Co* of *Hull* have been inspected by me as set forth below, and found to be, so far as can be seen, *Sound*

John C Craig
Newcastle

on Forgings.
Lloyd's
No. *54498*
86

	STERN FRAME.	RUDDER FRAME.	STEM.
Material	<i>Scrap Iron</i>	<i>Scrap Iron</i>	
Mode	<i>Forged</i>	<i>Forged</i>	
Dimensions	<i>6 - 2 1/2</i>	<i>3 1/2 - 2 1/4</i>	
Tests on Inspection	<i>Forged & Smithed</i>	<i>Forged & Smithed</i>	
When Inspected	<i>March 4-6-10-18/96</i>	<i>June 2-4-9-12/96</i>	

ETCHES OF FRAMES SHOWING POSITION AND DESCRIPTION OF WELDS OF FORGINGS, OR PARTICULARS OF TESTS APPLIED TO CASTINGS.

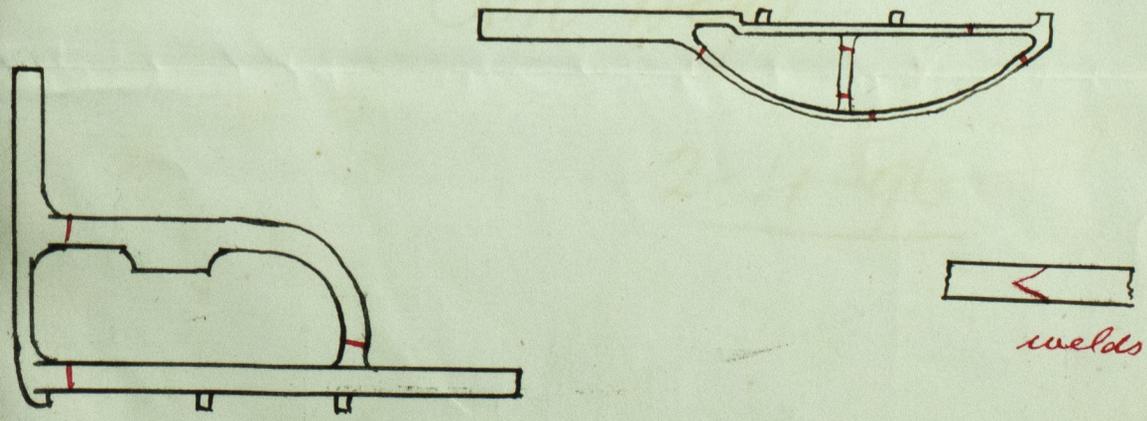

(if any chargeable) £

To be paid at

© 2019
Lloyd's Register
Foundation
LVL413-0020

* If of Iron, state whether scrap or puddled Iron.