

Boiler No. for 3 vessels T. 100
'Toronto' Jamaica + Trinidad

Received at

Hull

Office,

9/9/

159

Lloyd's Register of British and Foreign Shipping.

s/s *Trinidad*

(Report on Vessel No. *10402* Port *Hull*)

No. *3280* SHIP FORGINGS OR CASTINGS.

I have to report that the undermentioned Iron or Steel Forgings or Castings, manufactured by *Messrs Emerson Walker + Thompson* of *Dunston* for the Vessel No. *164*, being built by *Messrs Cook Melton & Co* of *Hull* have been inspected by me as set forth below, and found to be, so far as can be seen, *sound*

The words FORGINGS or CASTINGS, IRON or STEEL, should be struck out as may be required.


Mark on Forgings.

Lloyd's
No. *5155B*
JG

John C Craig
Newcastle
8-9-96

	STERN FRAME.	RUDDER FRAME.	STEM.
Material*	<i>Scrap Iron</i>	<i>Scrap Iron</i>	/
How made	<i>Forged</i>	<i>Forged</i>	
Dimensions	<i>6 - 2 1/2</i>	<i>3 1/2 - 2 1/4</i>	
Progress on Inspection	<i>Forged + Smithed</i>	<i>Forged + Smithed</i>	
Date when Inspected	<i>May 1 - to 22/96</i>	<i>August 5 to 27/96</i>	

SKETCHES OF FRAMES SHOWING POSITION AND DESCRIPTION OF WELDS OF FORGINGS, OR PARTICULARS OF TESTS APPLIED TO CASTINGS.

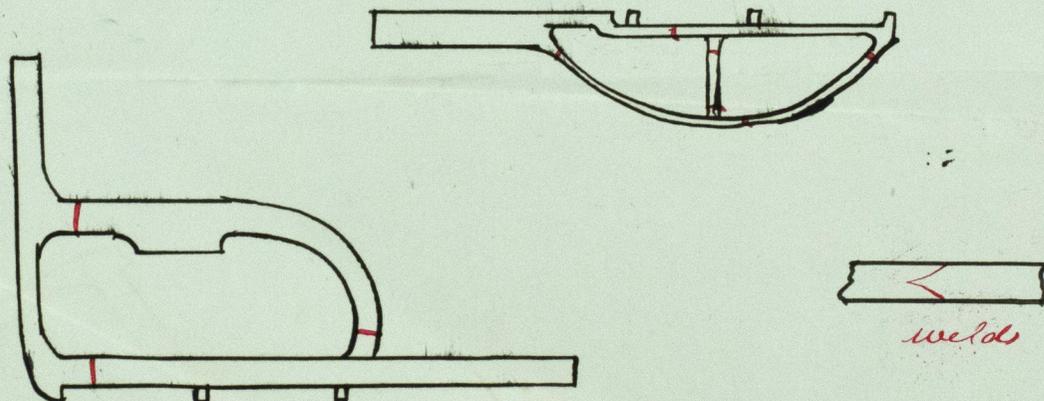

Fee (if any chargeable) £ : :

To be paid at



© 2019

Lloyd's Register Foundation

* If of Iron, state whether scrap or puddled Iron.