

5/ Languemois
Hull Report No. 11593

191

— 101 94.2.2 —


ORIGINAL SECTION

— 110-0-0 x 51-0 x 0-0 —


SECTION OF TAYLOR


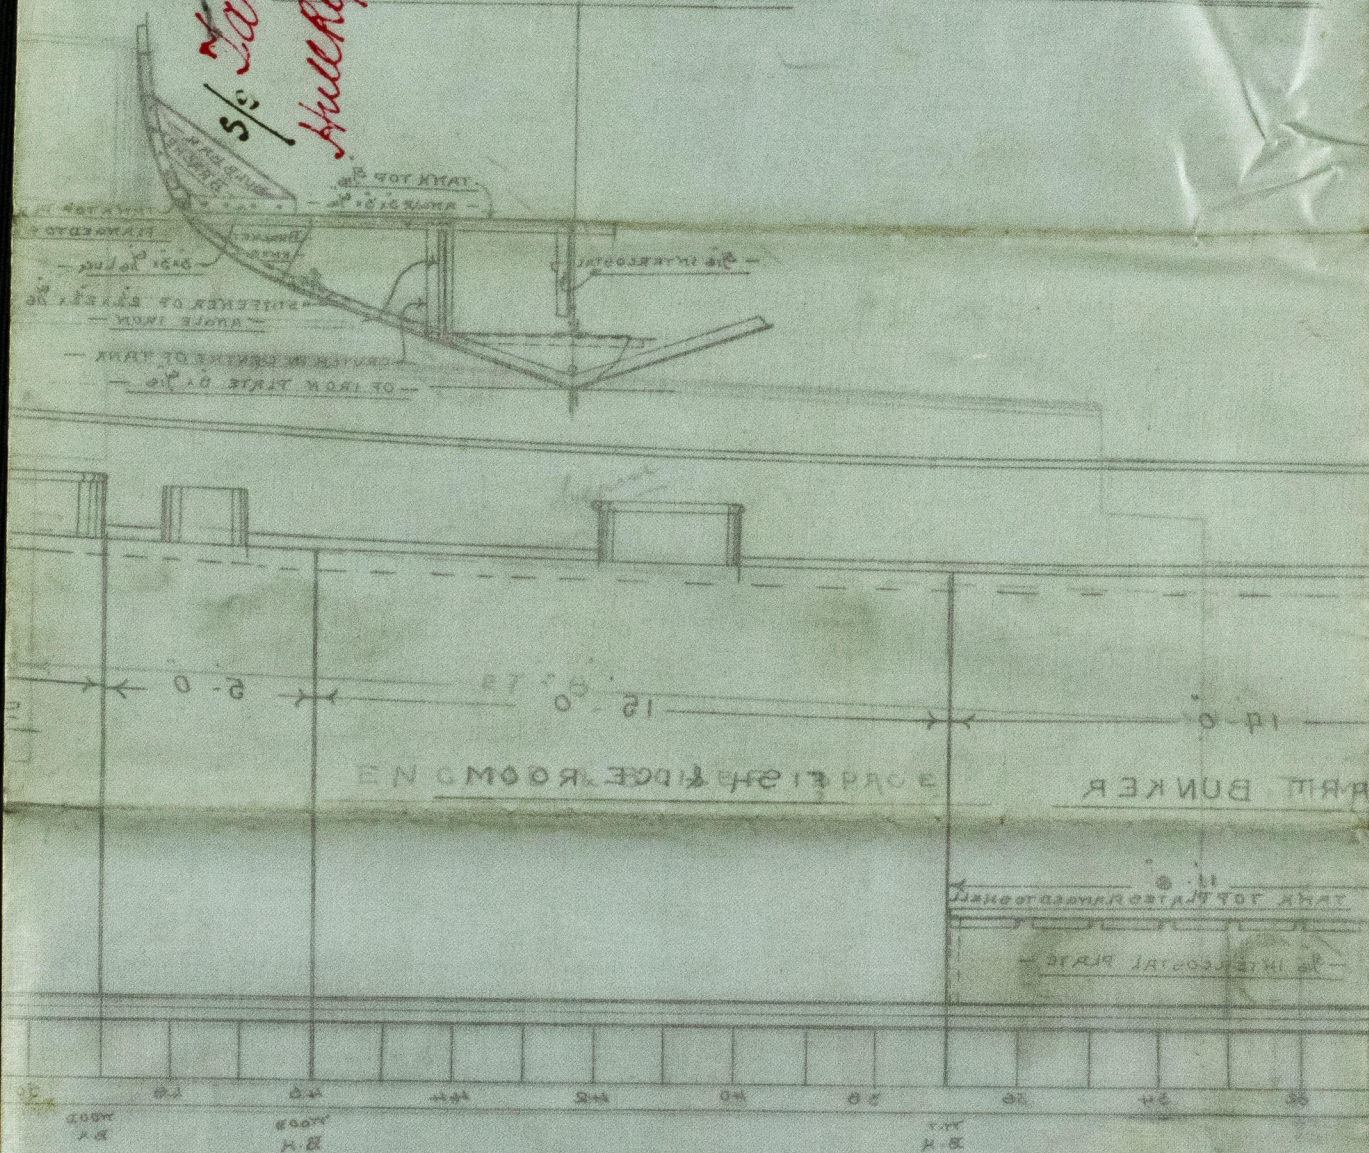

© 2019


Lloyd's Register
Foundation

LOYD'S REGISTER OF SHIPPING

23.4.97

S.S. No 191
LONGITUDINAL SECTION
110-0 x 21-0 x 11-0 HOLD
SCALE 1/4" = 1 FOOT

SECTION OF TANK
IN THWART BUNKER

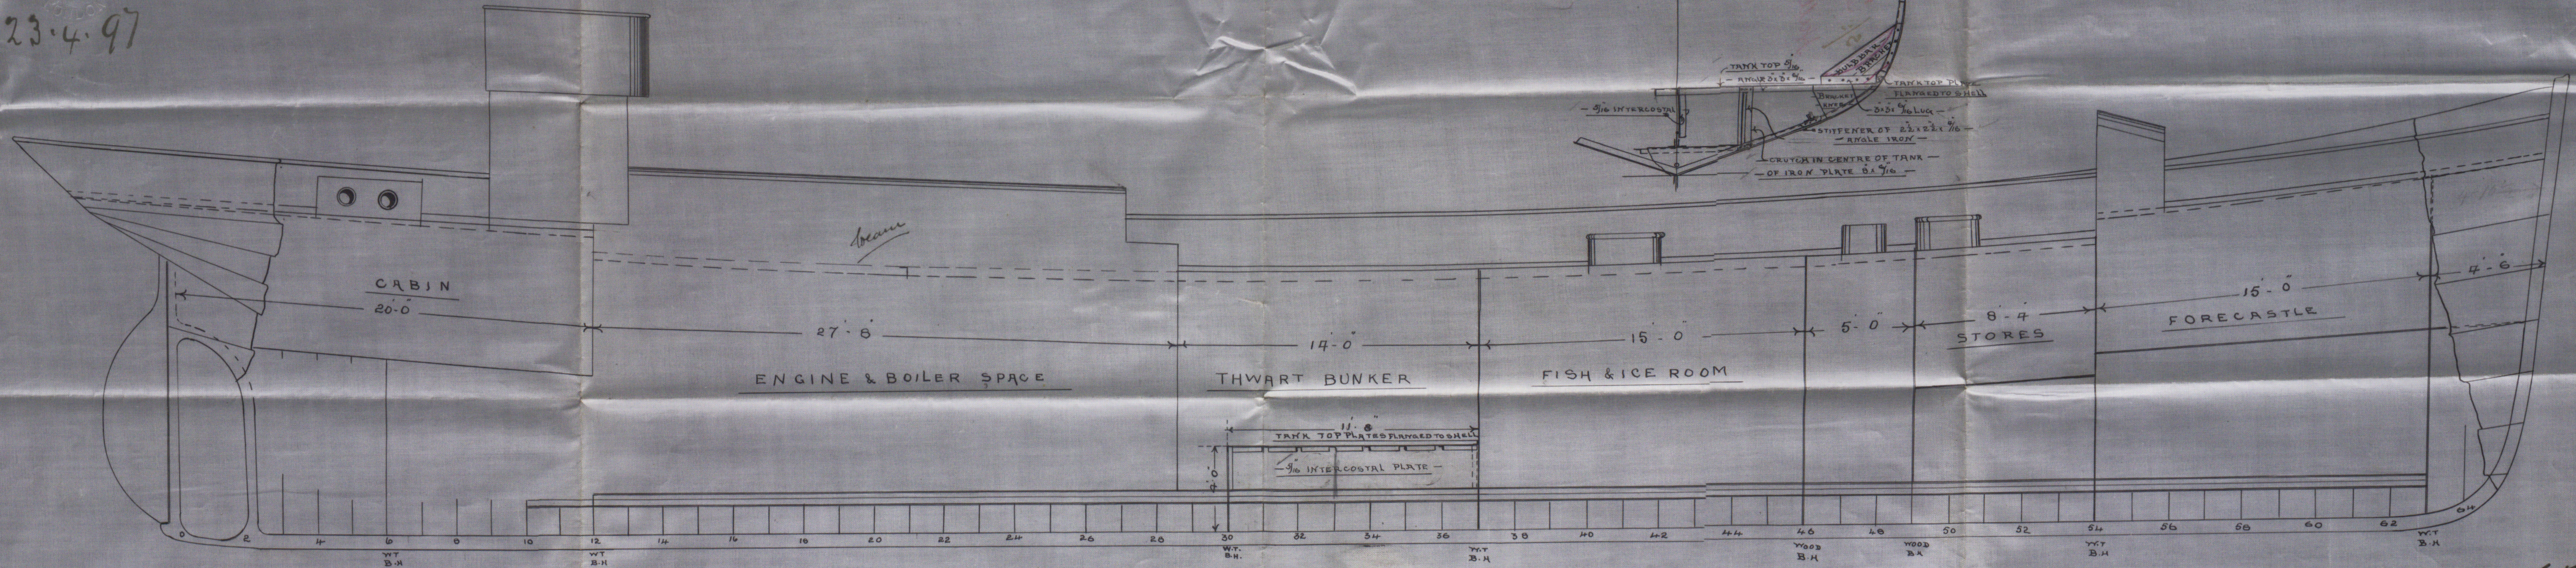

COCHRANE & COOPER
IRON & STEEL SHIPBUILDERS
BEVERLEY

J.F.L.
23/4/97

TRACING No 528
12/4/97