



## Lloyd's Register of British and Foreign Shipping.

*s/s Tarquennais*(Report on Vessel No. *11593*)Port *Hull*No. *3730*

## SHIP FORGINGS OR CASTINGS.

I have to report that the undermentioned Iron or Steel Forgings ~~or Castings~~,  
 manufactured by *Messrs Emerson Walker & Thompson*  
 of *Dunston* for the Vessel No. *191*, being built  
 by *Messrs Cochran & Co* of *Hull*  
 have been inspected by me as set forth below, and found to be, so far as can be seen,  
*sound*

Mark on Forgings.




Lloyd's

No. *6447B**JB*

*John B Craig*  
*Newcastle*

	STERN FRAME.	RUDDER FRAME.	STEM.
Material* ...	<i>Scrap</i>	<i>Scrap</i>	/
How made ...	<i>Forged</i>	<i>Forged</i>	
Dimensions ...	<i>6 - 2 1/2</i>	<i>3 1/2 - 2 1/4</i>	
Progress on Inspection	<i>Forged &amp; Smitted</i>	<i>Forged &amp; Smitted</i>	
Date when Inspected	<i>March 10 to April 2/97</i>	<i>May 17 to June 14/97</i>	

SKETCHES OF FRAMES SHOWING POSITION AND DESCRIPTION OF WELDS OF FORGINGS, OR PARTICULARS OF  
 TESTS APPLIED TO CASTINGS.

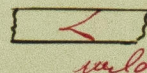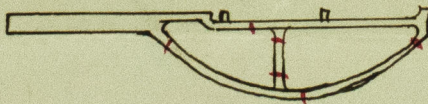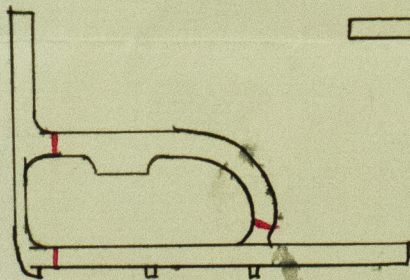

Fee (if any chargeable) £

To be paid at



© 2019

Lloyd's Register  
Foundation