

Charles N. 428
s/s "Plover"

Hull Report No. 11800

HUL416-0017



© 2019

Lloyd's Register
Foundation

16.6.97

No 428. As built
J. Thomson

Midship Section

Scale $\frac{1}{2}'' = 1 \text{ Foot}$


Dimensions per Rule $103.75 \times 21.0 \times 12.5$

Class 100 A.1. Steel



Numerals

$10.50 = \frac{1}{2}$ Breadth
 $18.62 = \frac{1}{2}$ Girth
 $12.44 = \text{Depth}$
 $41.56 = 1^{\text{st}}$ No.
 103.75
 207.80
 290.92
 124.68
 41.560
 $4311.8500 = 2^{\text{nd}}$ No.

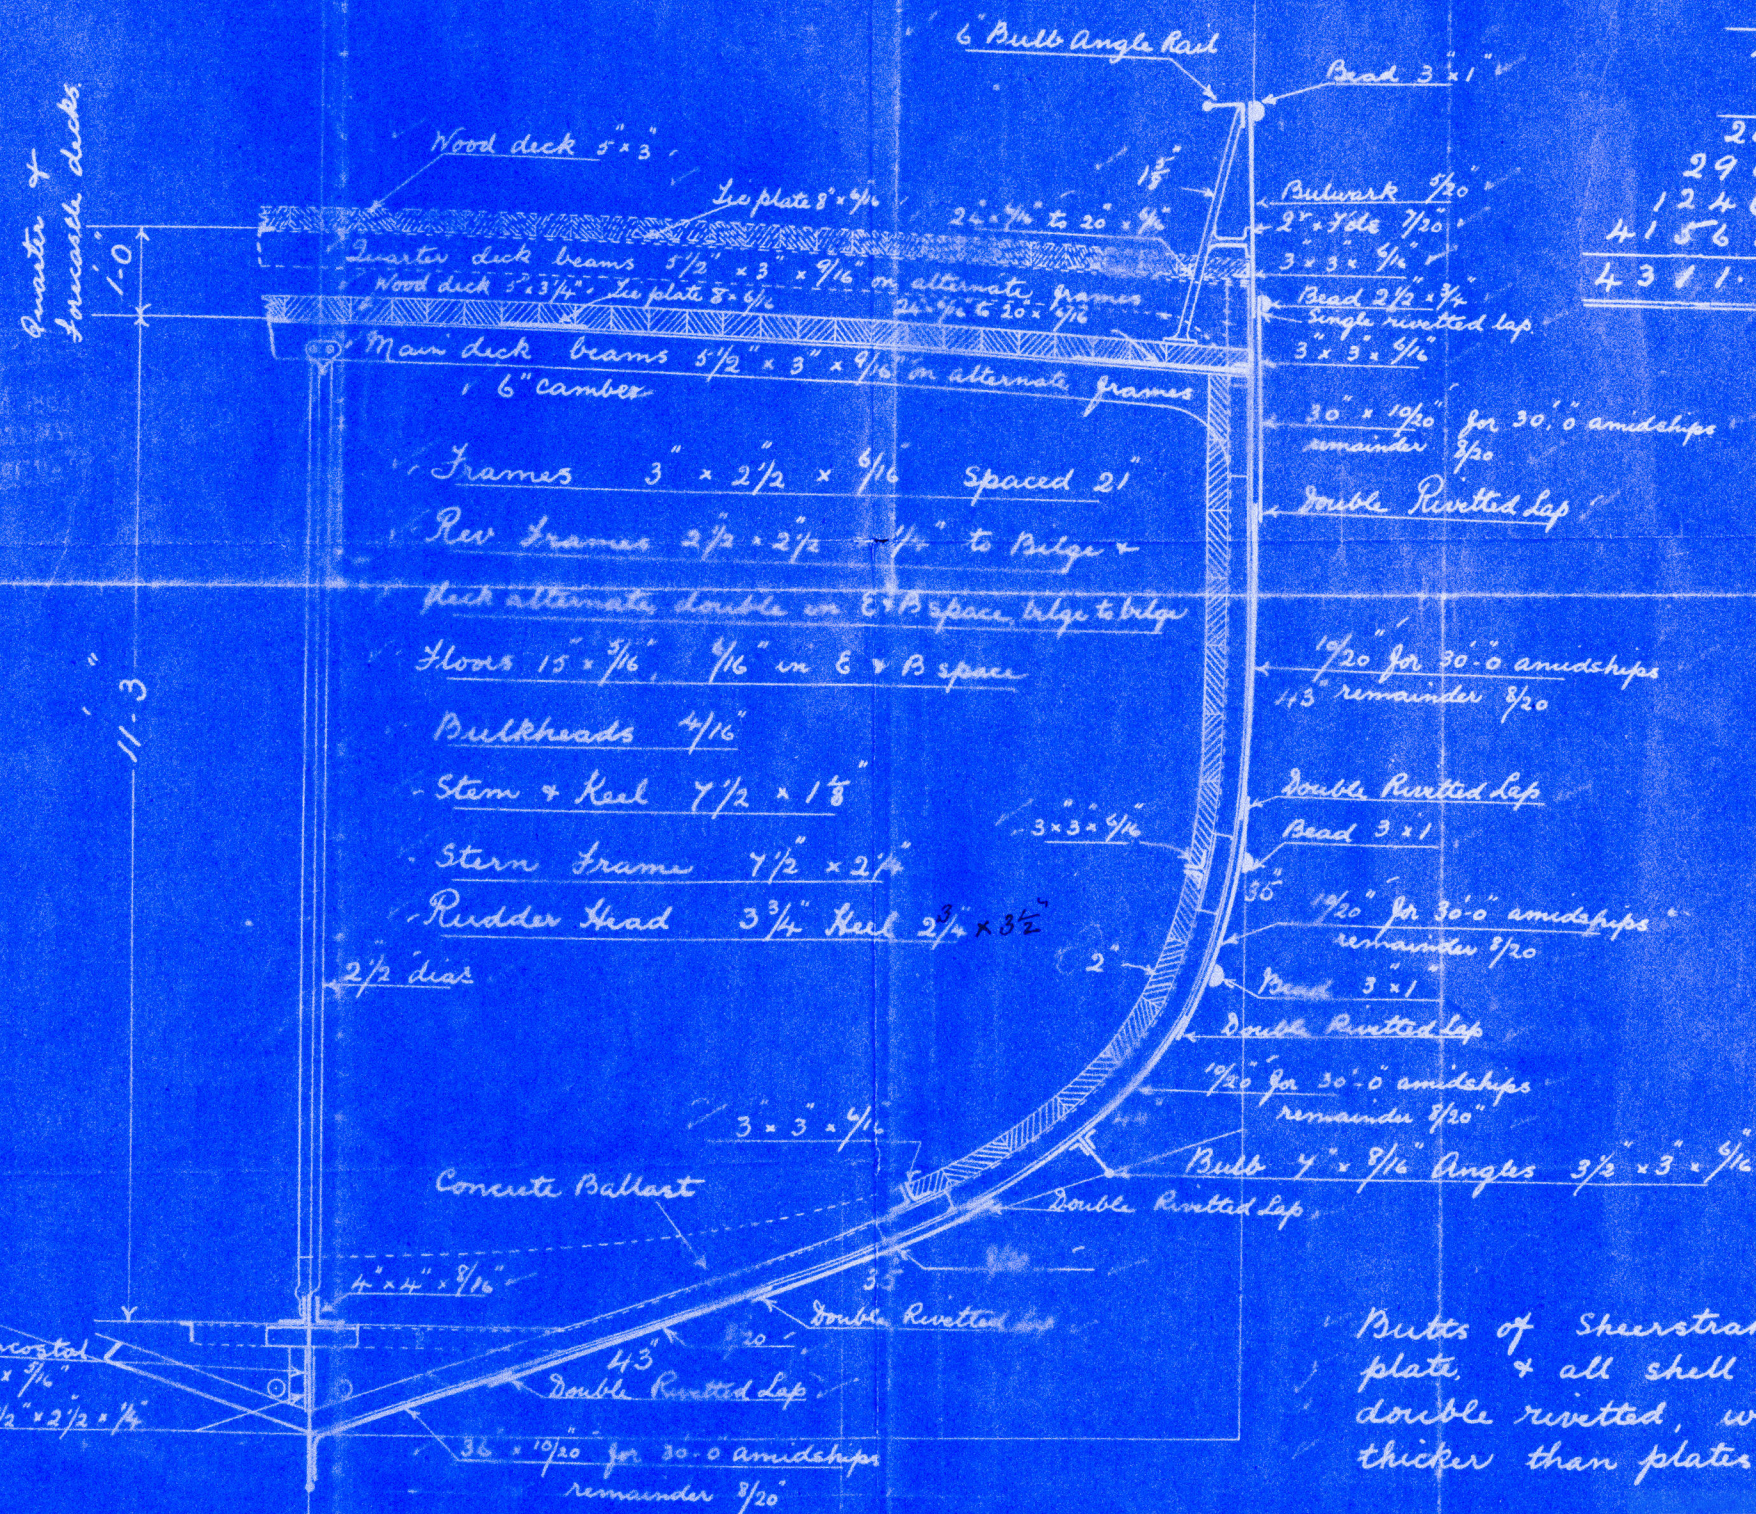

Butts of Sheerstrake, stringer plate, & all shell plating to be double rivetted, with straps $\frac{1}{16}''$ thicker than plates they connect.

Jb
16.6.97

J.T.

HULL 16.00