

REGISTERED  
SHIP  
HULL

16.6.97


- No 429. - As built  
J. Thomson

# Midship Section

Scale 1/2" = 1 Foot

Dimensions per Rule 103.75 x 21.0 x 12.5


Class 100 A.1. Steel

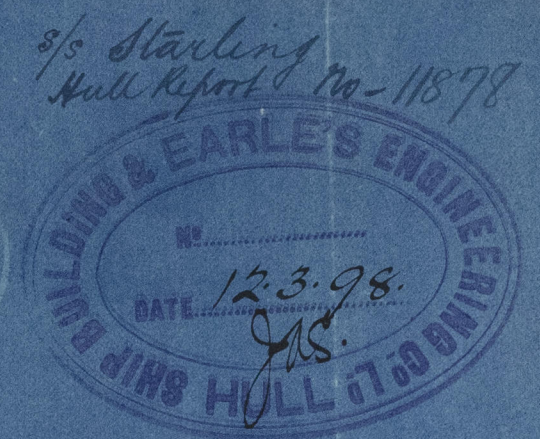

## Numerals

10.50 = 1/2 Breadth  
18.62 = 1/2 Girth  
12.44 = Depth  
41.56 = 1st No  
103.75  
207 80  
290 92  
124 68  
41560  
4311.8500 = 2nd No

Quarter & Forecastle decks

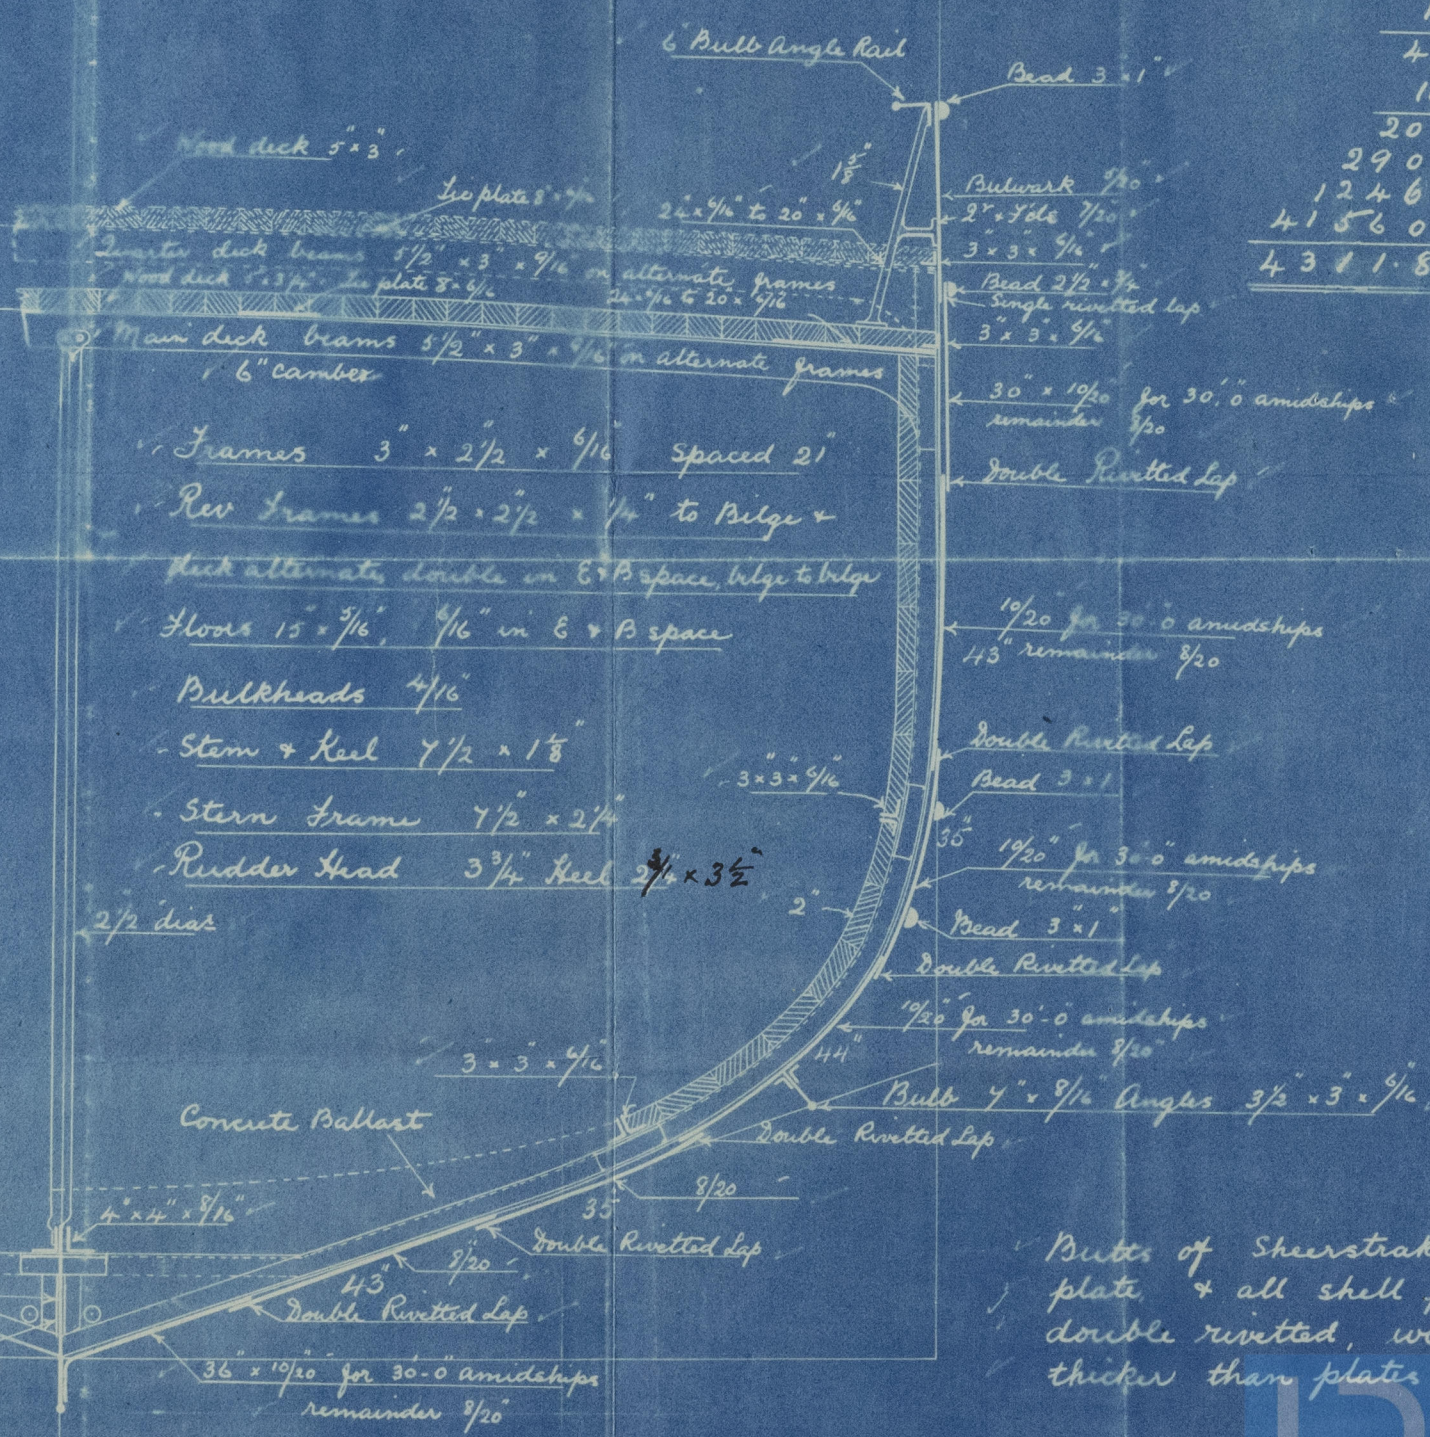

Butts of Sheerstrake, stringer plate & all shell plating to be double rivetted, with straps 1/20" thicker than plates they connect.

J.B.  
16.6.97

HULL 116-0072  
Hull Register  
Foundation



HULL416-0072



*s/s "Starling"*  
*Hull Report No. 11878*



© 2020

Lloyd's Register  
Foundation