

LOYD'S REGISTER OF SHIPPING  
RECEIVED  
19 JUN. 1897  
LONDON

203



W 171-2420 51.52

22225

1940

50210

10. 1. 1914

00.01 1750

© 2019

Lloyd's Register  
Foundation



21.6.97

# MIDSHIP SECTION S.S. No. 203

SCALE  $\frac{1}{2}$  INCH TO ONE FOOT  
100'-0" x 21'-0" x 11'-6" HOLD

$\frac{1}{2}$  GIRTH 18.66  
 $\frac{1}{2}$  BREADTH 10.46  
DEPTH 12.03  
41.94 1<sup>st</sup> No  
90.75  
20970  
29358  
33552  
34446  
4141.5750 2ND No




J.S.

DIMENSION	
LENGTH AS PER RULE	90'-9"
$\frac{1}{2}$ MLD BREADTH	10.52
DEPTH K TO M D B	12.10

RAISED Q<sup>B</sup> DECK

CLASS 100A1

RAISED FOLE DECK

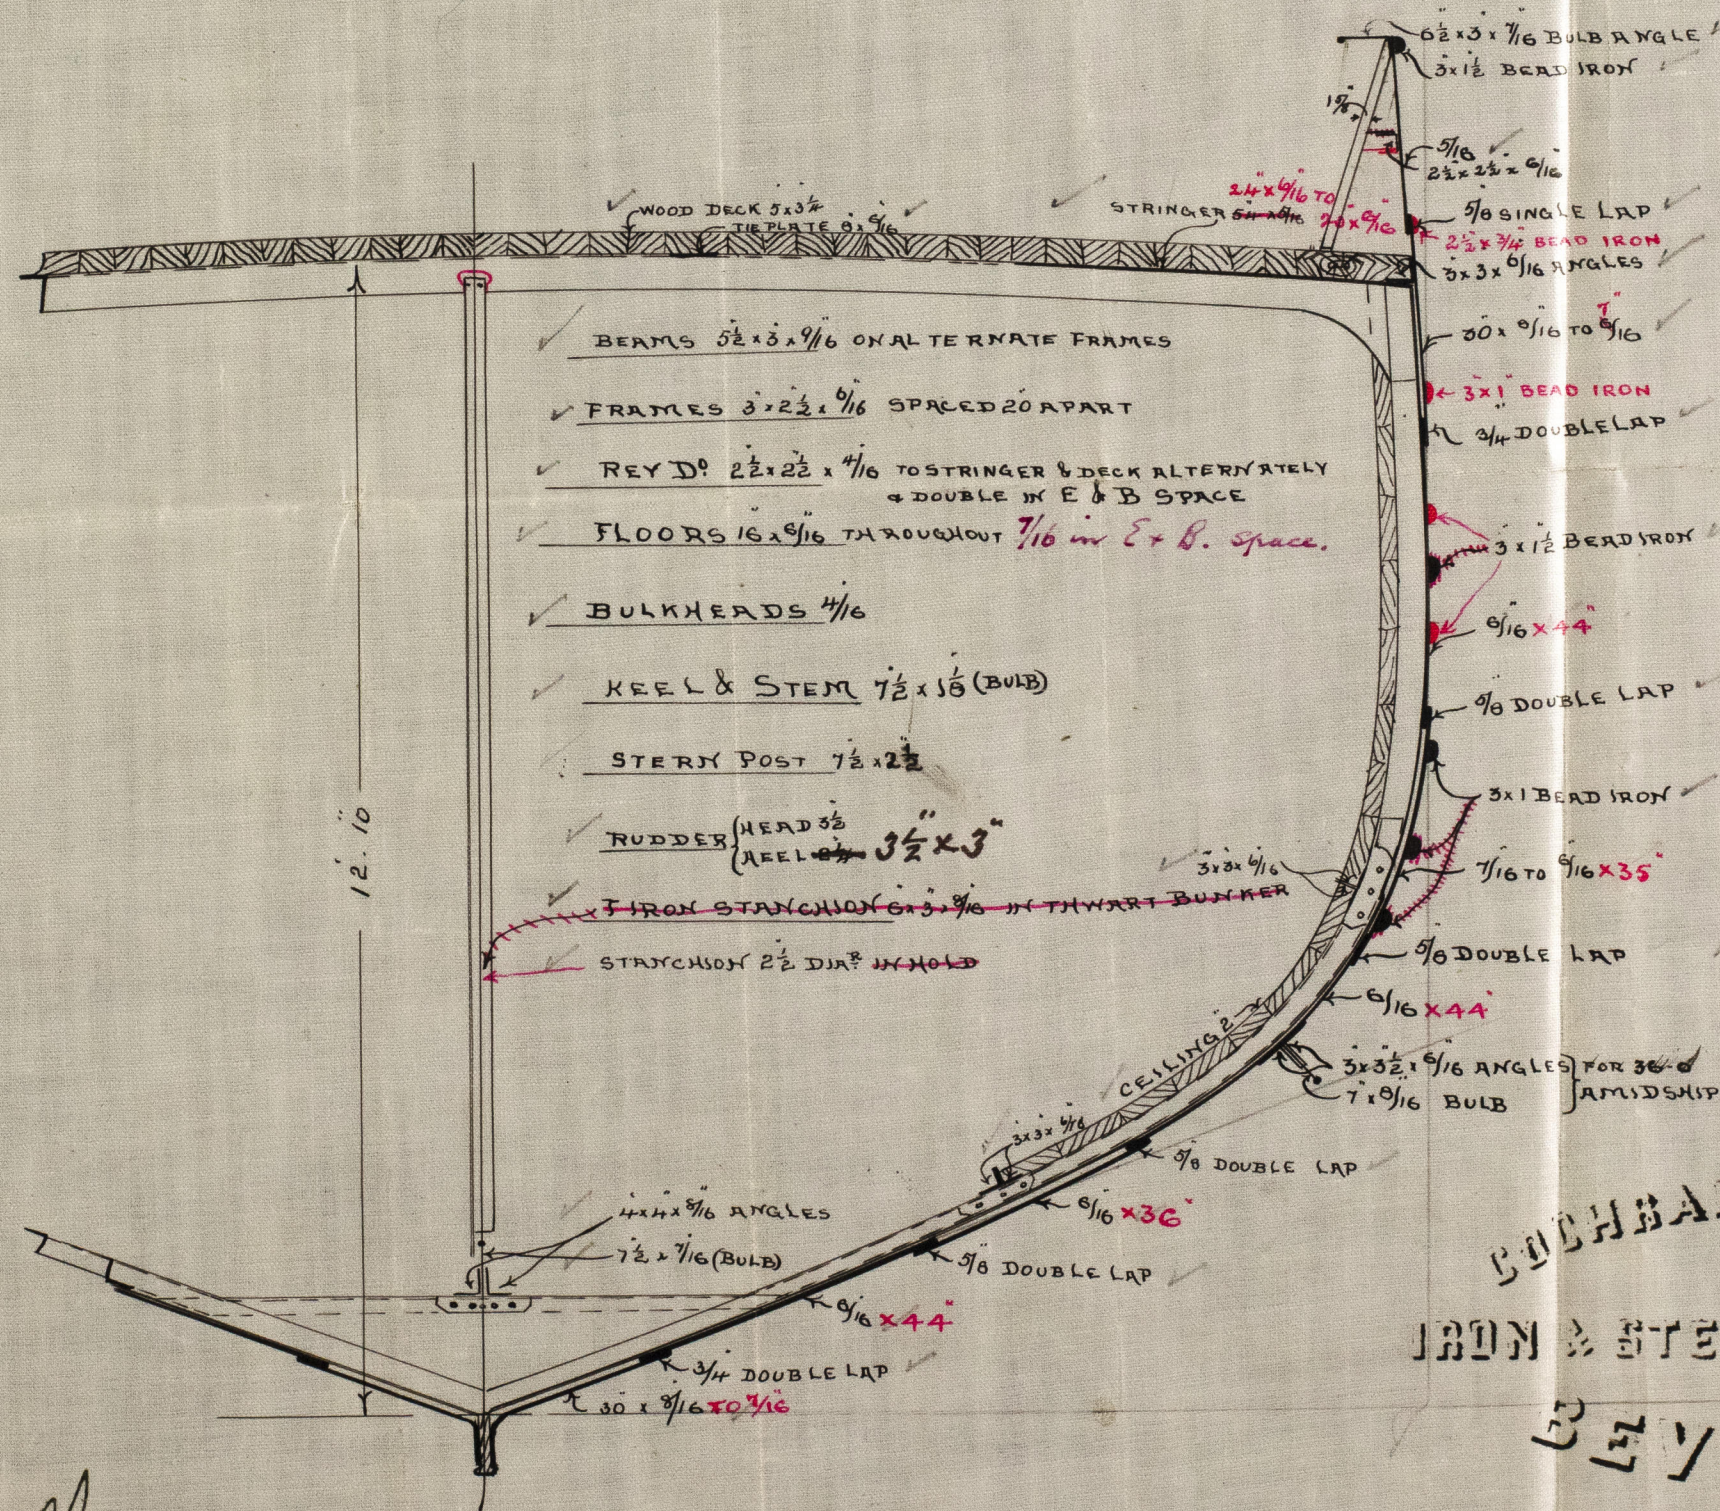

- BUTT STRAPS OF SHEER STRAKE
- STRINGER & STRAKE AT BILGE
- TO BE 1/16 THICKER THAN PLATES THEY CONNECT
- ALL DOUBLE RIVETTED

COCHRANE & COOPER  
IRON & STEEL SHIPBUILDERS  
BEVERLY



21.6.97

TRACING No 1014